



THE STATE OF NEW HAMPSHIRE
DEPARTMENT OF TRANSPORTATION



Victoria F. Sheehan
Commissioner

William Cass, P.E.
Assistant Commissioner

November 7, 2016

Gino Infascelli
Wetlands Bureau
NH Department of Environmental Services
29 Hazen Drive
Concord, NH 03301

Re: Bedford, 13953, X-A-000(143)
Amendment Submittal - NHDES Permit #2016-02893

Mr. Infascelli:

As discussed with the Natural Resource Agencies on October 19, 2016 (minutes attached), the project impacts to the streams were clarified and the appropriate mitigation for the proposed stream impacts throughout the project were assessed. In accordance with the plan of action discussed during the meeting, the following determinations were made on the project stream impacts.

1. The Tributary to Riddle Brook (Wetland #13) - Approximately 21 linear feet of the existing stone apron is being put back where it currently exists, this is a repair of an existing structure and mitigation is not required (Station 123+00R).
2. The Tributary to Riddle Brook (Wetland #14) - Approximately 155 linear feet of the existing man-made stone lined channel will be filled in and a stone-lined ditch re-created to the north of the existing channel. Mitigation will consist of planting live stakes 5 feet up from the ditch line on the roadway side of Red Osier Dogwood and Sand Bar Willow. These will be planted alternating species in groups of 5 in two rows, 5 feet on-center along the south slope of the new channel to provide for re-vegetation along the channel (Station 123+50L to 125+00L).
3. At Wetland #36 on Meetinghouse Road - It was determined that there is no intermittent stream located at the culvert outlet at Station 19+90L and therefore only wetland impacts will be calculated in this area.
4. The Tributary to Bowman Brook (Wetland # 54) - Approximately 518 linear feet of the channel will be impacted due to the widening of NH 101. A new stone-lined channel will be constructed to the south along the proposed roadway slope. Mitigation along the roadside will consist of live stakes 5 feet up from the ditch line of Silky Dogwood and Speckled Alder planted alternating species in groups of 5 in two rows, 5 feet on-center of the new channel. Mitigation along the wetland side will consist of planting live stakes of Silky Dogwood and Speckled Alder planted in a single row in groups of 5 alternating species, 5 feet on-center to provide for the re-vegetation along the new channel (Station 186+30R to 191+00R).
5. The Tributary to Bowman Brook (Wetland #57) - The impacts were revised to correct errors noted in the quantification of the impacts (Station 193+00R).
6. The Tributary to Bowman Brook (Wetland # 58) - Approximately 50 linear feet of the existing stone apron is being put back where it currently exists, this is a repair of an existing structure and mitigation is not required (Station 200+10R). Additionally, the impacts were revised to correct errors noted in the quantification of the impacts.

Additionally, the DOT proposes that the Bank impacts to Riddle Brook (Wetland #7) at Station 116+10L to 116+50L (Impact 7C, 41 linear feet), and the Tributary to Riddle Brook (Wetland #3) at Stations

110+20R to 114+00R (Impact 3A, 375 linear feet) and at Stations 114+70R to 116+50R (Impact 3B, 169 linear feet) are self-mitigating as the impacts, though permanent, will consist of reshaping the existing grassed roadway slopes and will not impact any shrubs or trees located adjacent to the channel of Riddle Brook nor to the Tributary to Riddle Brook. The new slopes will be stabilized and re-seeded with standard slope seeds.

Additional mitigation will be provided through an In-Lieu fee to the NHDES Aquatic Resource Mitigation (ARM) Fund of \$775,335.57 for Wetlands and \$101,446.56 for Streams impacts, for a total In-Lieu fee payment of **\$876,782.13** into the ARM fund.

Attached are revised Wetland Plans dated November 3, 2016 showing the revised impacts and that include the revised Wetland Impact Summary Table, Item 650.2 - Planting Proposal, and the revised Aquatic Resource Mitigation (ARM) Fund calculator form for the wetland and stream impacts.

In summary, the Revised impacts of the project are:


- **Permanent** impacts to **Wetlands** consisting of **153,267 square feet** (used in ARM fund Wetland Impact Calculator).
- **Permanent** impacts to **Streams** consisting of **6,379 square feet**.
- **Permanent** impacts to **Banks** consisting of **19,489 square feet**.
- **Temporary** impacts to **Wetlands** and **Streams** consisting of **56,415 square feet**.
- **Permanent** linear impacts to **Perennial Streams** channels of **774 linear feet** (80 linear feet of channel used in ARM fund Stream Impact Calculator).
- **Temporary** linear impacts to **Perennial Streams** channels of **149 linear feet**.
- **Permanent** linear impacts to **Banks** of **2,046 linear feet** (334 linear feet of bank used in ARM fund Stream Impact Calculator).
- **Temporary** linear impacts to **Banks** of **164 linear feet**.

The amended plans dated November 3, 2016 have been posted on the Departments' website and can be accessed via the following link: <http://www.nh.gov/dot/org/projectdevelopment/environment/units/program-management/wetland-applications.htm>.

The lead people to contact for this project are Victoria Chase, Project Manager (vchase@dot.nh.gov) or Marc Laurin, Senior Environment Manager, Bureau of Environment (271-3226 or mlaurin@dot.nh.gov).

If and when this application amendment meets with the approval of the NHDES, please send the permit directly to Matt Urban, Wetlands Program Manager, Bureau of Environment

Sincerely,

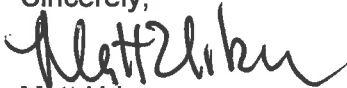

Matt Urban
Wetland Program Manager
NHDOT Bureau of Environment
(603) 271-7969

MRU:MGL:mgl

Enclosures

cc: Bureau of Environment (Original)
Lori Sommer, NHDES Wetlands
Bureau, w/attachments

Ted Diers, NHDES Watershed Bureau,
w/attachments
Michael Hicks, USACOE, w/attachments

Beth Evarts, Bedford Con. Comm.,
w/attachments
Victoria Chase, Project Manager
Kevin Nyhan, Bureau of Environment

2016 VALUES

| TOWN | Equalized Value per Acre |
|------------------|-----------------------------|
| ACWORTH | 1,510 |
| ALBANY | 800 |
| ALEXANDRIA | 2,373 |
| ALLENSTOWN | 5,874 |
| ALSTEAD | 2,211 |
| ALTON | 17,462 |
| AMHERST | 28,408 |
| ANDOVER | 3,565 |
| ANTRIM | 3,245 |
| ASHLAND | 10,784 |
| ATKINSON | 35977 |
| AUBURN | 18,641 |
| BARNSTEAD | 6,141 |
| BARRINGTON | 10,286 |
| BARTLETT | 4,937 |
| BATH | 1,592 |
| BEAN'S GRANT | 380 |
| BEAN'S PURCHASE | 380 |
| BEDFORD | 35,977 |
| BELMONT | 10,881 |
| BENNINGTON | 3,345 |
| BENTON | 380 |
| BERLIN | 720 |
| BETHLEHEM | 916 |
| BOSCAWEN | 4,587 |
| BOW | 17,421 |
| BRADFORD | 3,147 |
| BRENTWOOD | 16,545 |
| BRIDGEWATER | 12,396 |
| BRISTOL | 9,928 |
| BROOKFIELD | 2,213 |
| BROOKLINE | 14,979 |
| CAMBRIDGE | 380 |
| CAMPTON | 3,521 |
| CANAAN | 3,594 |
| CANDIA | 8,052 |
| CANTERBURY | 3,365 |
| CARROLL | 2,382 |
| CENTER HARBOR | 22,597 |
| CHANDLER'S PURCH | 380 |
| CHARLESTOWN | 2,012 |
| CHATHAM | 476 |

DES AQUATIC RESOURCE MITIGATION FUI WETLAND PAYMENT CALCULATION

INSERT AMOUNTS IN YELLOW CELLS

| | |
|-----------------------------------------------------------------------------------------------------------|-----------------------------------|
| 1 Convert square feet of impact to acres | |
| INSERT SQ FT OF IMPACT | Square feet of impact = 153267.00 |
| | Acres of impact = 43560.00 |
| | 3.5185 |
| 2 Determine acreage of wetland construction | |
| | Forested wetlands: 5.2778 |
| | Tidal wetlands: 10.5556 |
| | All other areas: 5.2778 |
| 3 Wetland construction cost: | |
| | Forested wetlands: \$456,233.95 |
| | Tidal Wetlands: \$912,467.91 |
| | All other areas: \$456,233.95 |
| 4 Land acquisition cost (See land value) | |
| INSERT LAND VALUE FROM TABLE WHICH APPEARS TO THE LEFT. (Insert the amount do not copy and paste.) | Town land value: 35977 |
| | Forested wetlands: \$189,879.02 |
| | Tidal wetlands: \$379,758.05 |
| | All other areas: \$189,879.02 |
| 5 Construction + land costs: | |
| | Forested wetland: \$646,112.98 |
| | Tidal wetlands: \$1,292,225.95 |
| | All other areas: \$646,112.98 |
| 6 DES Administrative cost: | |
| | Forested wetlands: \$129,222.60 |
| | Tidal wetlands: \$258,445.19 |
| | All other areas: \$129,222.60 |
| ***** TOTAL ARM PAYMENT***** | |
| | Forested wetlands: \$775,335.57 |
| | Tidal wetlands: \$1,550,671.15 |
| | All other areas: \$775,335.57 |

**DES AQUATIC RESOURCE MITIGATION FUND
STREAM PAYMENT CALCULATION**

| | | |
|-----------------------------------------------------------------------|---------------------------------|---------------------|
| INSERT LINEAR FEET OF IMPACT on BOTH BANKS AND CHANNEL | Right Bank | 334.00 |
| | Left Bank | |
| | Channel | 80.0000 |
| | | |
| | TOTAL IMPACT | 414.0000 |
| | | |
| | Stream Impact Cost: | \$84,538.80 |
| | | |
| | DES Administrative cost: | |
| | | \$16,907.76 |
| ***** TOTAL ARM FUND STREAM PAYMENT***** | | |
| | | \$101,446.56 |

With Deductions

| | | | |
|------------------------|-------------------------------------------------------------|-------------|------------|
| | BEDFORD 13953 | | |
| ITEM NUMBER | | UNIT | QTY |
| 650.2 | | | |
| | STA. 186+30 - 191+00 | | |
| | Cornus amomum, Silky Dogwood, 4' Live Stakes | EA | 140 |
| | Alnus incana, Speckled Alder, 18" - 24" 1 gal. Potted Cont. | EA | 140 |
| | | | |
| | STA. 123+50 - 125+00 | | |
| | Cornus sericea, Red Osier Dogwood 4' Live Stakes | EA | 30 |
| | Salix exigua, Sand Bar Willow, 4' Live Stakes | EA | 30 |
| | | | |
| | Total Plants | | 340 |
| | | | |


| |
|------------------------------------------------------------------------------------------------|
| Notes: |
| Live stakes to be planted during dormancy (late fall to early spring). |
| Do not allow live stakes to dry out. |
| |
| Sta. 186+30 - 191+00 |
| Roadside - Begin plantings 5' up from ditch line, two rows in groups of 5 alternating species. |
| Back side - Plant a single row in groups of 5 alternating species. |
| Spacing 5' OC |
| |
| Sta. 123+50 - 125+00 |
| Roadside - Begin plantings 5' up from ditch line, two rows in groups of 5 alternating species. |
| Spacing 5' OC |
| |
| Watering and mulch (3" depth) subsidiary to 650.2 spec |
| |

STATE OF NEW HAMPSHIRE
DEPARTMENT OF TRANSPORTATION
WETLAND PLANS
FEDERAL AID PROJECT

X-A000(143)
NH PROJECT NO. 13953
NH ROUTE 101


| DESIGN DATA | | | |
|-----------------------------|---------|-----------------------------|--------|
| NH ROUTE 101 | | WALLACE ROAD | |
| AVERAGE DAILY TRAFFIC 20 17 | 34,000 | AVERAGE DAILY TRAFFIC 20 17 | 8,800 |
| AVERAGE DAILY TRAFFIC 20 37 | 41,000 | AVERAGE DAILY TRAFFIC 20 37 | 11,000 |
| PERCENT OF TRUCKS | 7% | PERCENT OF TRUCKS | - |
| DESIGN SPEED | 40 mph | DESIGN SPEED | 35 mph |
| LENGTH OF PROJECT | 2.20 mi | LENGTH OF PROJECT | 700 ft |

| MEETINGHOUSE ROAD | |
|-----------------------------|----------|
| AVERAGE DAILY TRAFFIC 20 17 | 5,800 |
| AVERAGE DAILY TRAFFIC 20 37 | 7,100 |
| PERCENT OF TRUCKS | - |
| DESIGN SPEED | 30 mph |
| LENGTH OF PROJECT | 1,030 ft |

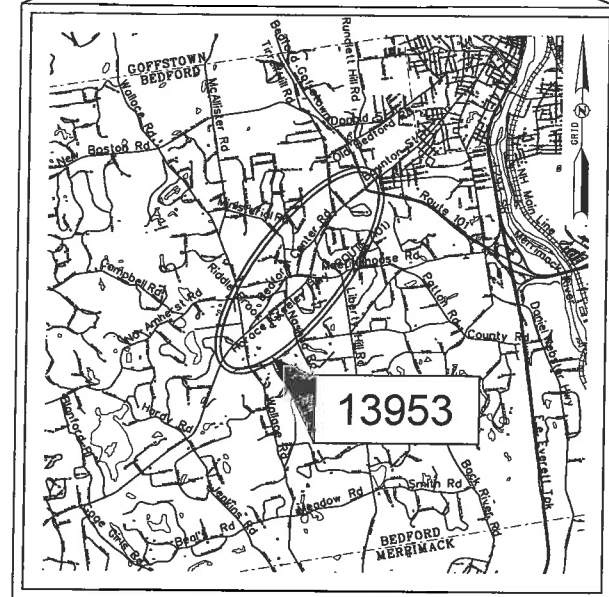

LOCATION MAP

GRAPHIC SCALE
0 1/2 1 2 mi.

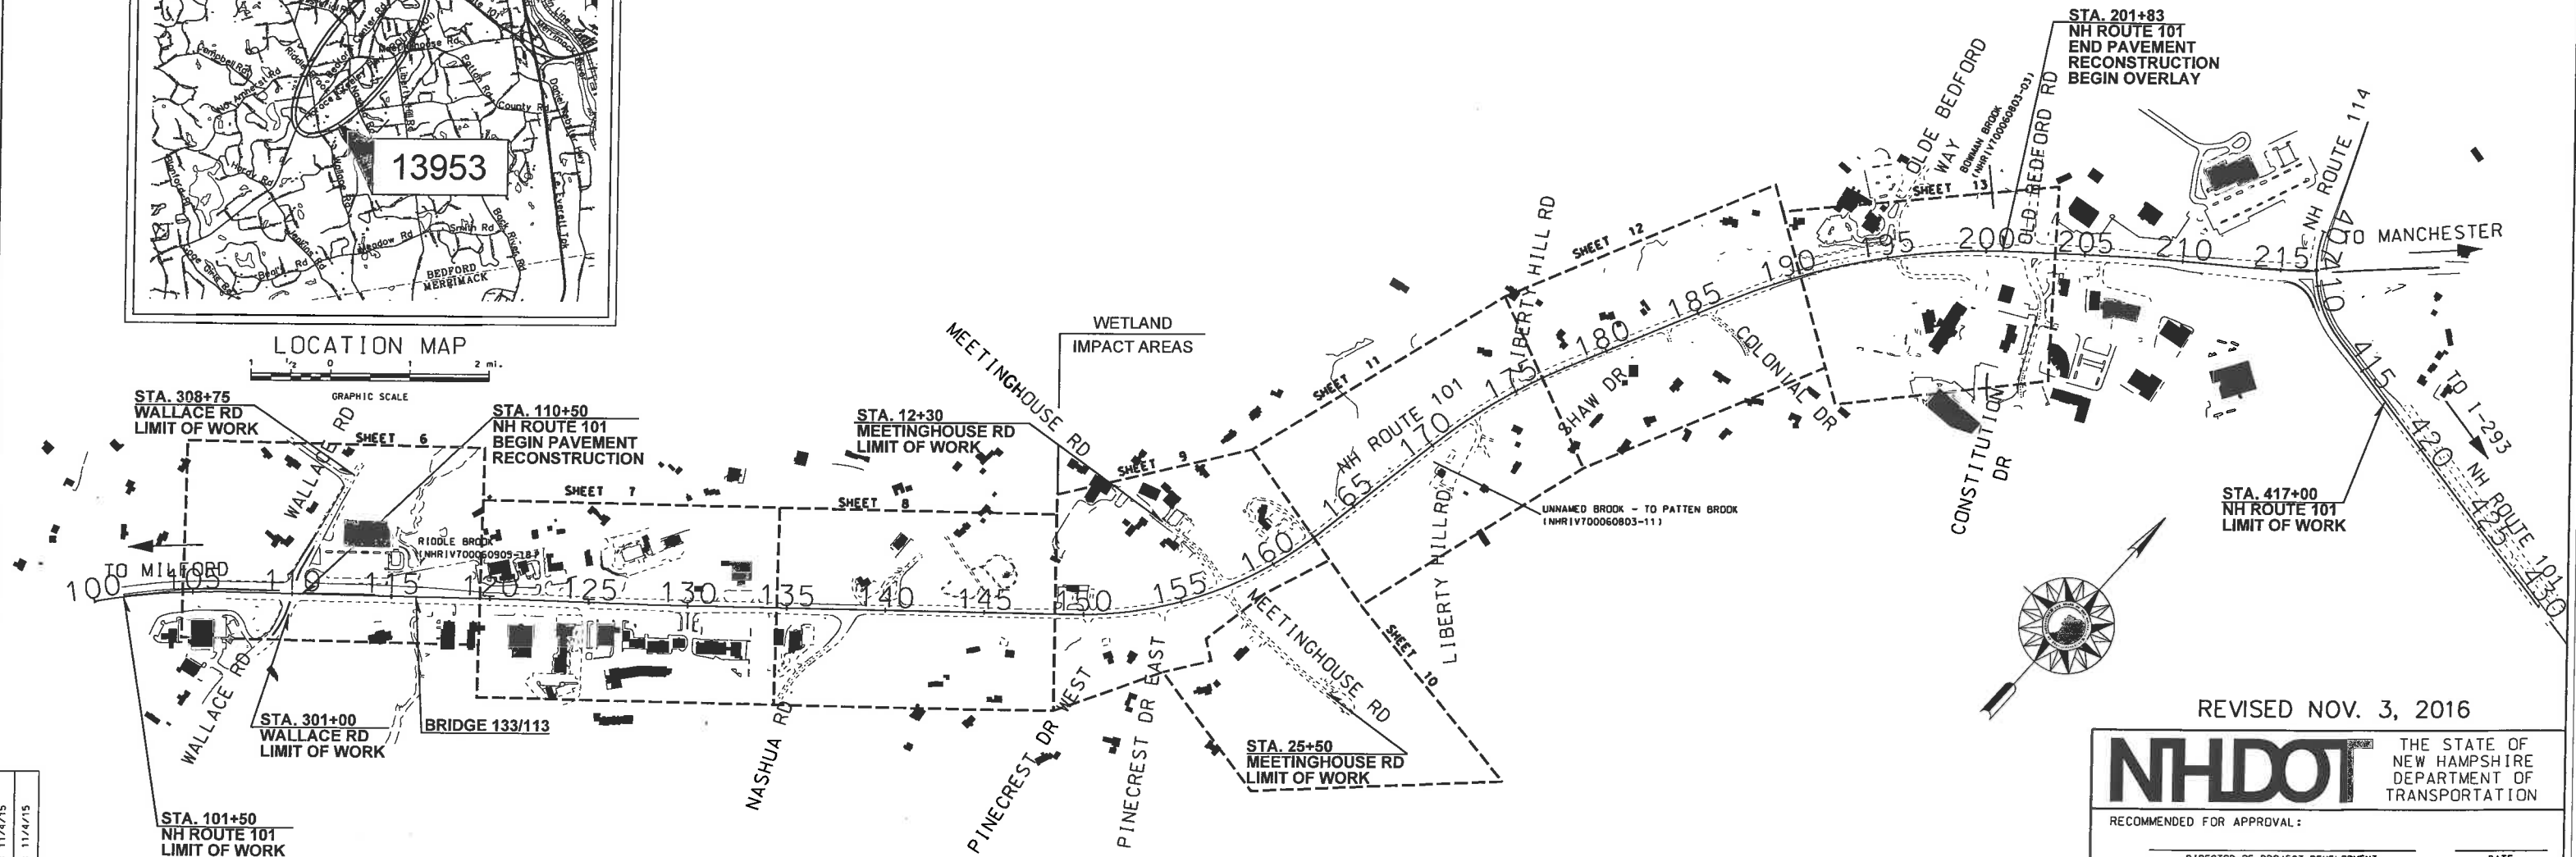

INDEX OF SHEETS

- 1 FRONT SHEET
- 2-3 NHDOT STANDARD SYMBOLS
- 4 EROSION CONTROL STRATEGIES
- 5 WETLAND IMPACT SUMMARY
- 6-15 WETLAND IMPACT PLANS
- 16-25 EROSION CONTROL PLANS

TOWN OF BEDFORD
COUNTY OF HILLSBOROUGH

SCALE: 1"=1,000'

FOR CONSTRUCTION AND ALIGNMENT DETAILS - SEE CONSTRUCTION PLANS

REVISED NOV. 3, 2016

NHDOT THE STATE OF
NEW HAMPSHIRE
DEPARTMENT OF
TRANSPORTATION

RECOMMENDED FOR APPROVAL:

DIRECTOR OF PROJECT DEVELOPMENT DATE

APPROVED:

ASSISTANT COMMISSIONER AND CHIEF ENGINEER DATE

U. S. DEPARTMENT OF
TRANSPORTATION
FEDERAL HIGHWAY ADMINISTRATION

APPROVED:

DIVISION ADMINISTRATOR DATE

| FEDERAL PROJECT NO. | STATE PROJECT NO. | SHEET NO. | TOTAL SHEETS |
|---------------------|-------------------|-----------|--------------|
| X-A000(143) | 13953 | 1 | 25 |

GENERAL

| | | | |
|----------------------------------|----------------------------------------------|--------------------------------------|-------------------------------------------|
| EDGE OF PAVEMENT TRAVELED WAY | PROPOSED ROADWAY | existing roadway | (pavement removed outside slope lines) |
| DRIVEWAYS | | (label surface type) | |
| BUILDINGS | | (label house or type of building) | (building to be removed) |
| FOUNDATION | | (label type) | |
| LEACH FIELD | | leach field | |
| BRIDGE CROSSINGS | STREAM | OVERPASS | |
| STEPS AND WALK | | (label type) | |
| INTERMITTENT WATER COURSE | | | |
| SHORE LINE | river/stream | pond (label name of water body) | |
| POTENTIAL WET AREA SYMBOL | | | |
| BRUSH OR WOODS LINE | | | |
| TREES (PLANS) | (deciduous) (coniferous) (stump) | | |
| TREE OR STUMP (CROSS-SECTIONS) | (show station, circumference in feet & type) | | |
| HEDGE | | (label type) | |
| MONITORING WELL | mon | | |
| WELL | W | | |
| FLAG POLE | fp | | |

ORIGINAL GROUND
(TYPICALS)

ROCK OUTCROP

ROCK LINE
(TYPICALS & SECTIONS ONLY)

GUARDRAIL (label type)

JERSEY BARRIER

CURB (LABEL TYPE)

STONE WALL

RETAINING WALL (LABEL TYPE)

FENCE (LABEL TYPE)

SIGNS

GAS PUMP

FUEL TANK (ABOVE GROUND)

STORAGE TANK FILLER CAP

SEPTIC TANK

GRAVE

MAILBOX

VENT PIPE

SATELLITE DISH ANTENNA

PHONE

GROUND LIGHT/LAMP POST



 

 
 
BORING LOCATION

TEST PIT

INTERSTATE NUMBERED HIGHWAY

UNITED STATES NUMBERED HIGHWAY

STATE NUMBERED HIGHWAY

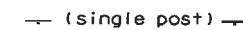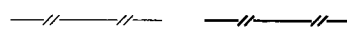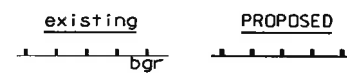

SHORELAND - WETLAND

WETLAND DESIGNATION AND TYPE

DELINEATED WETLAND
ORDINARY HIGH WATER
TOP OF BANK
TOP OF BANK & ORDINARY HIGH WATER
NORMAL HIGH WATER
WIDTH AT BANK FULL
PRIME WETLAND
PRIME WETLAND 100' BUFFER
NON-JURISDICTIONAL DRAINAGE AREA
COWARDIN DISTINCTION LINE
TIDAL BUFFER ZONE
DEVELOPED TIDAL BUFFER ZONE
HIGHEST OBSERVABLE TIDE LINE
MEAN HIGH WATER
MEAN LOW WATER
VERNAL POOL
SPECIAL AQUATIC SITE
REFERENCE LINE
WATER FRONT BUFFER
NATURAL WOODLAND BUFFER
PROTECTED SHORELAND
INVASIVE SPECIES LABEL

| | | |
|-------------|-------------|-------------|
| | 2 PUB2E | |
| — DW — | — DW — | — DW — |
| — OHW — | — OHW — | — OHW — |
| — TOB — | — TOB — | — TOB — |
| — TOBOHW — | — TOBOHW — | — TOBOHW — |
| — NHW — | — NHW — | — NHW — |
| — WBF — | — WBF — | — WBF — |
| — PWET — | — PWET — | — PWET — |
| — PWET100 — | — PWET100 — | — PWET100 — |
| — NJDA — | — NJDA — | — NJDA — |
| — CDL — | — CDL — | — CDL — |
| — TBZ — | — TBZ — | — TBZ — |
| — DTBZ — | — DTBZ — | — DTBZ — |
| — HOTL — | — HOTL — | — HOTL — |
| — MHW — | — MHW — | — MHW — |
| — MLW — | — MLW — | — MLW — |
| — VP — | — VP — | — VP — |
| — SAS — | — SAS — | — SAS — |
| — REF — | — REF — | — REF — |
| — WBSO — | — WBSO — | — WBSO — |
| — NWB150 — | — NWB150 — | — NWB150 — |
| — PS250 — | — PS250 — | — PS250 — |
| — INV — | — INV — | — INV — |

FLOODPLAIN / FLOODWAY

500 YEAR FLOODPLAIN BOUNDARY
100 YEAR FLOODPLAIN BOUNDARY
FLOODWAY

| | |
|-----------|-----------|
| — FP500 — | — FP500 — |
| — FP100 — | — FP100 — |
| — FW — | — FW — |

ENGINEERING

CONSTRUCTION BASELINE
PC, PT, POT (ON CONST BASELINE)
PI (IN CONSTRUCTION BASELINES)
INTERSECTION OR EQUATION OF
TWO LINES
ORIGINAL GROUND LINE
(PROFILES AND CROSS-SECTIONS)
PROFILE GRADE LINE
(PROFILES AND CROSS-SECTIONS)

| | | |
|----|----|----|
| 30 | 31 | 32 |
|----|----|----|




CLEARING LINE
SLOPE LINE

SLOPE LINE (FILL)

SLOPE LINE (CUT)

PROFILES AND CROSS SECTIONS:
ORIGINAL GROUND ELEVATION (LEFT)
FINISHED GRADE ELEVATION (RIGHT)

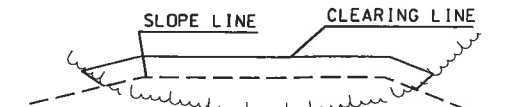

| | |
|------|-------|
| 72.5 | 79.14 |
|------|-------|

SHEET 1 OF 2



Louis Berger
Manchester, New Hampshire
(603) 644 5200

REVISION DATE
11-21-2014

| | | | |
|---------------------------------------------------------|-------------------|-----------|--------------|
| STATE OF NEW HAMPSHIRE | | | |
| DEPARTMENT OF TRANSPORTATION • BUREAU OF HIGHWAY DESIGN | | | |
| STANDARD SYMBOLS | | | |
| DGN | STATE PROJECT NO. | SHEET NO. | TOTAL SHEETS |
| 13953_std symb1_2 | 13953 | 2 | 25 |

DRAINAGE

| | | |
|-----------------------------------------|--|--------------------------------|
| MANHOLE | | |
| CATCH BASIN | | (existing) |
| DROP INLET | | (PROPOSED) |
| DRAINAGE PIPE (existing) | | (label size & type) |
| DRAINAGE PIPE (PROPOSED) | | (label size & type) |
| UNDERDRAIN (existing) W/ FLUSHING BASIN | | (label size & type) |
| UNDERDRAIN (PROPOSED) W/ FLUSHING BASIN | | (label size & type) |
| HEADER (existing & PROPOSED) | | (with stone outlet protection) |
| END SECTION (existing & PROPOSED) | | METAL or PLASTIC |
| OPEN DITCH (PROPOSED) | | RCP |
| EROSION CONTROL/ STONE SLOPE PROTECTION | | |

BOUNDARIES / RIGHT-OF-WAY

| | | |
|--------------------------------|--|---------------|
| RIGHT-OF-WAY LINE | | (label type) |
| RR RIGHT-OF-WAY LINE | | |
| PROPERTY LINE | | |
| PROPERTY LINE (COMMON OWNER) | | |
| TOWN LINE | | BOW |
| COUNTY LINE | | CONCORD |
| STATE LINE | | COOS |
| NATIONAL FOREST | | GRAFTON |
| CONSERVATION LAND | | MAINE |
| BENCH MARK / SURVEY DISK | | NEW HAMPSHIRE |
| BOUND | | |
| STATE LINE/ TOWN LINE MONUMENT | | bnd |
| NHDOT PROJECT MARKER | | (PROPOSED) |
| IRON PIPE OR PIN | | |
| DRILL HOLE IN ROCK | | |
| TAX MAP AND LOT NUMBER | | |
| PROPERTY PARCEL NUMBER | | |
| HISTORIC PROPERTY | | |

UTILITIES

| | | |
|------------------------------------------------------------------------|--|-------------------------------------------|
| TELEPHONE POLE | | |
| POWER POLE | | |
| JOINT OCCUPANCY | | (plot point at face not center of symbol) |
| MISCELLANEOUS/UNKNOWN POLE | | |
| GUY POLE OR PUSH BRACE | | |
| LIGHT POLE | | |
| LIGHT ON POWER POLE | | |
| LIGHT ON JOINT POLE | | |
| POLE STATUS: REMOVE, LEAVE, PROPOSED, OR TEMPORARY AS APPLICABLE e.g.: | | |
| RAILROAD | | |
| RAILROAD SIGN | | |
| RAILROAD SIGNAL | | |
| UTILITY JUNCTION BOX | | |
| OVERHEAD ELECTRIC | | |
| UNDERGROUND UTILITIES | | |
| WATER (on existing lines label size, type and note if abandoned) | | |
| SEWER | | |
| TELEPHONE | | |
| ELECTRIC | | |
| GAS | | |
| LIGHTING | | |
| INTELLIGENT TRANSPORTATION SYSTEM | | |
| FIBER OPTIC | | |
| WATER SHUT OFF | | |
| GAS SHUT OFF | | |
| HYDRANT | | |
| MANHOLES | | |
| SEWER | | |
| TELEPHONE | | |
| ELECTRICAL | | |
| GAS | | |
| UNKNOWN | | |

TRAFFIC SIGNALS / ITS

| | | |
|------------------------------------------------------------|--|--------------|
| MAST ARM (existing) | | (existing) |
| OPTICOM RECEIVER | | |
| OPTICOM STROBE | | |
| TRAFFIC SIGNAL | | |
| PEDESTAL WITH PEDESTRIAN SIGNAL HEADS AND PUSH BUTTON UNIT | | |
| SIGNAL CONDUIT | | |
| CONTROLLER CABINET | | |
| METER PEDESTAL | | |
| PULL BOX | | |
| LOOP DETECTOR (QUADRUPOLE) | | (label size) |
| LOOP DETECTOR (RECTANGULAR) | | (label size) |
| CAMERA POLE (CCTV) | | |
| FIBER OPTIC DELINEATOR | | |
| FIBER OPTIC SPLICE VAULT | | |
| ITS EQUIPMENT CABINET | | |
| VARIABLE SPEED LIMIT SIGN | | |
| DYNAMIC MESSAGE SIGN | | |
| ROAD AND WEATHER INFO SYSTEM | | |

CONSTRUCTION NOTES

| | |
|-------------------------------|-----|
| CURB MARK NUMBER - BITUMINOUS | B-1 |
| CURB MARK NUMBER - GRANITE | G-1 |
| CLEARING AND GRUBBING AREA | A |
| DRAINAGE NOTE | 1 |
| EROSION CONTROL NOTE | A |
| FENCING NOTE | A |
| GUARDRAIL NOTE | 1 |
| ITS NOTE | 1 |
| LIGHTING NOTE | A |
| TRAFFIC SIGNAL NOTE | 1 |

SHEET 2 OF 2



Louis Berger
Manchester, New Hampshire
(603) 644 5200

REVISION DATE
11-21-2014

| | | | |
|---------------------------------------------------------|-------------------|-----------|--------------|
| STATE OF NEW HAMPSHIRE | | | |
| DEPARTMENT OF TRANSPORTATION • BUREAU OF HIGHWAY DESIGN | | | |
| STANDARD SYMBOLS | | | |
| DCN | STATE PROJECT NO. | SHEET NO. | TOTAL SHEETS |
| 13953_s+dsymb1_2 | 13953 | 3 | 25 |

EROSION CONTROL STRATEGIES

1. ENVIRONMENTAL COMMITMENTS:
- 1.1. THESE GUIDELINES DO NOT RELIEVE THE CONTRACTOR FROM COMPLIANCE WITH ANY CONTRACT PROVISIONS, OR APPLICABLE FEDERAL, STATE, AND LOCAL REGULATIONS.
- 1.2. THIS PROJECT WILL BE SUBJECT TO THE US EPA'S NATIONAL POLLUTANT DISCHARGE ELIMINATION SYSTEM (NPDES) STORM WATER CONSTRUCTION GENERAL PERMIT AS ADMINISTERED BY THE ENVIRONMENTAL PROTECTION AGENCY (EPA). THIS PROJECT IS SUBJECT TO REQUIREMENTS IN THE MOST RECENT CONSTRUCTION GENERAL PERMIT (CGP).
- 1.3. THE CONTRACTOR'S ATTENTION IS DIRECTED TO THE NHDES WETLAND PERMIT, THE US ARMY CORPS OF ENGINEERS PERMIT, WATER QUALITY CERTIFICATION AND THE SPECIAL ATTENTION ITEMS INCLUDED IN THE CONTRACT DOCUMENTS.
- 1.4. ALL STORM WATER, EROSION AND SEDIMENT CONTROL MEASURES SHALL BE INSTALLED AND MAINTAINED IN ACCORDANCE WITH THE NEW HAMPSHIRE STORMWATER MANUAL, VOLUME 3, EROSION AND SEDIMENT CONTROLS DURING CONSTRUCTION (DECEMBER 2008) (BMP MANUAL) AVAILABLE FROM THE NEW HAMPSHIRE DEPARTMENT OF ENVIRONMENTAL SERVICES (NHDES).
- 1.5. THE CONTRACTOR SHALL COMPLY WITH RSA 485-A:17, AND ALL, PUBLISHED NHDES ALTERATION OF TERRAIN ENV-WO 1500 REQUIREMENTS ([HTTP://DES.NH.GOV/ORGANIZATION/COMMISSIONER/LEGAL/RULES/INDEX.HTM](http://DES.NH.GOV/ORGANIZATION/COMMISSIONER/LEGAL/RULES/INDEX.HTM))
- 1.6. THE CONTRACTOR IS DIRECTED TO REVIEW AND COMPLY WITH SECTION 107.1 OF THE CONTRACT AS IT REFERS TO SPILLAGE, AND ALSO WITH REGARDS TO EROSION, POLLUTION, AND TURBIDITY PRECAUTIONS.
2. STANDARD EROSION CONTROL SEQUENCING APPLICABLE TO ALL CONSTRUCTION PROJECTS:
- 2.1. PERIMETER CONTROLS SHALL BE INSTALLED PRIOR TO EARTH DISTURBING ACTIVITIES. PERIMETER CONTROLS AND STABILIZED CONSTRUCTION EXITS SHALL BE INSTALLED AS SHOWN IN THE BMP MANUAL AND AS DIRECTED BY THE STORMWATER POLLUTION PREVENTION PLAN (SWPPP) PREPARER.
- 2.2. EROSION, SEDIMENTATION CONTROL MEASURES AND INFILTRATION BASINS SHALL BE CLEANED, REPLACED AND AUGMENTED AS NECESSARY TO PREVENT SEDIMENTATION BEYOND PROJECT LIMITS THROUGHOUT THE PROJECT DURATION.
- 2.3. EROSION AND SEDIMENT CONTROL MEASURES SHALL BE INSPECTED IN ACCORDANCE WITH THE CONSTRUCTION GENERAL PERMIT AND SECTION 645 OF THE NHDOT SPECIFICATIONS FOR ROAD AND BRIDGES CONSTRUCTION.
- 2.4. AN AREA SHALL BE CONSIDERED STABLE IF ONE OF THE FOLLOWING HAS OCCURRED:
- (A) BASE COURSE GRAVELS HAVE BEEN INSTALLED IN AREAS TO BE PAVED;
- (B) A MINIMUM OF 85% VEGETATED GROWTH HAS BEEN ESTABLISHED;
- (C) A MINIMUM OF 3" OF NON-EROSIVE MATERIAL SUCH AS STONE OR RIP-RAP HAS BEEN INSTALLED;
- (D) TEMPORARY SLOPE STABILIZATION CONFORMING TO TABLE 1 HAS BEEN PROPERLY INSTALLED
- 2.5. ALL STOCKPILES SHALL BE CONTAINED WITH A PERIMETER CONTROL. IF THE STOCKPILE IS TO REMAIN UNDISTURBED FOR MORE THAN 14 DAYS, MULCHING WILL BE REQUIRED.
- 2.6. A WATER TRUCK SHALL BE AVAILABLE TO CONTROL EXCESSIVE DUST AT THE DIRECTION OF THE CONTRACT ADMINISTRATOR.
- 2.7. TEMPORARY EROSION AND SEDIMENTATION CONTROL MEASURES SHALL REMAIN UNTIL THE AREA HAS BEEN PERMANENTLY STABILIZED.
- 2.8. CONSTRUCTION PERFORMED ANY TIME BETWEEN NOVEMBER 30th AND MAY 1st OF ANY YEAR SHALL BE CONSIDERED WINTER CONSTRUCTION AND SHALL CONFORM TO THE FOLLOWING REQUIREMENTS.
- (A) ALL PROPOSED VEGETATED AREAS WHICH DO NOT EXHIBIT A MINIMUM OF 85% VEGETATIVE GROWTH BY OCTOBER 15th, OR WHICH ARE DISTURBED AFTER OCTOBER 15th, SHALL BE STABILIZED IN ACCORDANCE WITH TABLE 1.
- (B) ALL DITCHES OR SWALES WHICH DO NOT EXHIBIT A MINIMUM OF 85% VEGETATIVE GROWTH BY OCTOBER 15th, OR WHICH ARE DISTURBED AFTER OCTOBER 15th, SHALL BE STABILIZED TEMPORARILY WITH STONE OR IN ACCORDANCE WITH TABLE 1.
- (C) AFTER NOVEMBER 30th INCOMPLETE ROAD SURFACES, WHERE WORK HAS STOPPED FOR THE SEASON, SHALL BE PROTECTED IN ACCORDANCE WITH TABLE 1.
- (D) WINTER EXCAVATION AND EARTHWORK SHALL BE DONE SUCH THAT NO MORE THAN 1 ACRE OF THE PROJECT IS WITHOUT STABILIZATION AT ONE TIME, UNLESS A WINTER CONSTRUCTION PLAN HAS BEEN APPROVED BY NHDOT THAT MEETS THE REQUIREMENTS OF ENV-WO 1505.02 AND ENV-WO 1505.05.
- (E) A SWPPP AMENDMENT SHALL BE SUBMITTED TO THE DEPARTMENT, FOR APPROVAL, ADDRESSING COLD WEATHER STABILIZATION (ENV-WO 1505.05) AND INCLUDING THE REQUIREMENTS OF NO LESS THAN 30 DAYS PRIOR TO THE COMMENCEMENT OF WORK SCHEDULED AFTER NOVEMBER 30th.
- GENERAL CONSTRUCTION PLANNING AND SELECTION OF STRATEGIES TO CONTROL EROSION AND SEDIMENT ON HIGHWAY CONSTRUCTION PROJECTS
3. PLAN ACTIVITIES TO ACCOUNT FOR SENSITIVE SITE CONDITIONS:
- 3.1. CLEARLY FLAG AREAS TO BE PROTECTED IN THE FIELD AND PROVIDE CONSTRUCTION BARRIERS TO PREVENT TRAFFICKING OUTSIDE OF WORK AREAS.
- 3.2. CONSTRUCTION SHALL BE SEQUENCED TO LIMIT THE DURATION AND AREA OF EXPOSED SOILS.
- 3.3. PROTECT AND MAXIMIZE EXISTING NATIVE VEGETATION AND NATURAL FOREST BUFFERS BETWEEN CONSTRUCTION ACTIVITY AND SENSITIVE AREAS.
- 3.4. WHEN WORK IS PERFORMED IN AND NEAR WATER COURSES, STREAM FLOW DIVERSION METHODS SHALL BE IMPLEMENTED PRIOR TO ANY EXCAVATION OR FILLING.
- 3.5. WHEN WORK IS PERFORMED WITHIN 50 FEET OF SURFACE WATERS (WETLAND, OPEN WATER OR FLOWING WATER), PERIMETER CONTROL SHALL BE ENHANCED CONSISTENT WITH SECTION 2.1.2.1. OF THE 2012 NPDES CONSTRUCTION GENERAL PERMIT.
4. MINIMIZE THE AMOUNT OF EXPOSED SOIL:
- 4.1. CONSTRUCTION SHALL BE SEQUENCED TO LIMIT THE DURATION AND AREA OF EXPOSED SOILS. MINIMIZE THE AREA OF EXPOSED SOIL AT ANY ONE TIME. PHASING SHALL BE USED TO REDUCE THE AMOUNT AND DURATION OF SOIL EXPOSED TO THE ELEMENTS AND VEHICLE TRACKING.
- 4.2. UTILIZE TEMPORARY MULCHING OR PROVIDE ALTERNATE TEMPORARY STABILIZATION ON EXPOSED SOILS IN ACCORDANCE WITH TABLE 1.
- 4.3. THE MAXIMUM AMOUNT OF DISTURBED EARTH SHALL NOT EXCEED A TOTAL OF 5 ACRES FROM MAY 1st THROUGH NOVEMBER 30th, OR EXCEED ONE ACRE DURING WINTER MONTHS, UNLESS THE CONTRACTOR DEMONSTRATES TO THE DEPARTMENT THAT THE ADDITIONAL AREA OF DISTURBANCE IS NECESSARY TO MEET THE CONTRACTORS CRITICAL PATH METHOD SCHEDULE (CPM), AND THE CONTRACTOR HAS ADEQUATE RESOURCES AVAILABLE TO ENSURE THAT ENVIRONMENTAL COMMITMENTS WILL BE MET.
5. CONTROL STORMWATER FLOWING ONTO AND THROUGH THE PROJECT:
- 5.1. DIVERT OFF SITE RUNOFF OR CLEAN WATER AWAY FROM THE CONSTRUCTION ACTIVITY TO REDUCE THE VOLUME THAT NEEDS TO BE TREATED ON SITE.
- 5.2. DIVERT STORM RUNOFF FROM UPSLOPE DRAINAGE AREAS AWAY FROM DISTURBED AREAS, SLOPES, AND AROUND ACTIVE WORK AREAS AND TO A STABILIZED OUTLET LOCATION.
- 5.3. CONSTRUCT IMPERMEABLE BARRIERS AS NECESSARY TO COLLECT OR DIVERT CONCENTRATED FLOWS FROM WORK OR DISTURBED AREAS.
- 5.4. STABILIZE, TO APPROPRIATE ANTICIPATED VELOCITIES, CONVEYANCE CHANNELS OR PUMPING SYSTEMS NEEDED TO CONVEY CONSTRUCTION STORMWATER TO BASINS AND DISCHARGE LOCATIONS PRIOR TO USE.
- 5.5. DIVERT OFF-SITE WATER THROUGH THE PROJECT IN AN APPROPRIATE MANNER SO NOT TO DISTURB THE UPSTREAM OR DOWNSTREAM SOILS, VEGETATION OR HYDROLOGY BEYOND THE PERMITTED AREA.
6. PROTECT SLOPES:
- 6.1. INTERCEPT AND DIVERT STORM RUNOFF FROM UPSLOPE DRAINAGE AREAS AWAY FROM UNPROTECTED AND NEWLY ESTABLISHED AREAS AND SLOPES TO A STABILIZED OUTLET OR CONVEYANCE.
- 6.2. CONSIDER HOW GROUNDWATER SEEPAGE ON CUT SLOPES MAY IMPACT SLOPE STABILITY AND INCORPORATE APPROPRIATE MEASURES TO MINIMIZE EROSION.
- 6.3. CONVEY STORMWATER DOWN THE SLOPE IN A STABILIZED CHANNEL OR SLOPE DRAIN.
- 6.4. THE OUTER FACE OF THE FILL SLOPE SHOULD BE IN A LOOSE RUFFLED CONDITION PRIOR TO TURF ESTABLISHMENT. TOPSOIL OR HUMUS LAYERS SHALL BE TRACKED UP AND DOWN THE SLOPE, DISKED, HARROWED, DRAGGED WITH A CHAIN OR MAT, MACHINE-RAKED, OR HAND-WORKED TO PRODUCE A RUFFLED SURFACE.
7. ESTABLISH STABILIZED CONSTRUCTION EXITS:
- 7.1. INSTALL AND MAINTAIN CONSTRUCTION EXITS, ANYWHERE TRAFFIC LEAVES A CONSTRUCTION SITE ONTO A PUBLIC RIGHT-OF-WAY.
- 7.2. SWEEP ALL CONSTRUCTION RELATED DEBRIS AND SOIL FROM THE ADJACENT PAVED ROADWAYS AS NECESSARY.
8. PROTECT STORM DRAIN INLETS:
- 8.1. DIVERT SEDIMENT LADEN WATER AWAY FROM INLET STRUCTURES TO THE EXTENT POSSIBLE.
- 8.2. INSTALL SEDIMENT BARRIERS AND SEDIMENT TRAPS AT INLETS TO PREVENT SEDIMENT FROM ENTERING THE DRAINAGE SYSTEM.
- 8.3. CLEAN CATCH BASINS, DRAINAGE PIPES, AND CULVERTS IF SIGNIFICANT SEDIMENT IS DEPOSITED.
- 8.4. DROP INLET SEDIMENT BARRIERS SHOULD NEVER BE USED AS THE PRIMARY MEANS OF SEDIMENT CONTROL AND SHOULD ONLY BE USED TO PROVIDE AN ADDITIONAL LEVEL OF PROTECTION TO STRUCTURES AND DOWN-GRADIENT SENSITIVE RECEPTORS.
9. SOIL STABILIZATION:
- 9.1. WITHIN THREE DAYS OF THE LAST ACTIVITY IN AN AREA, ALL EXPOSED SOIL AREAS, WHERE CONSTRUCTION ACTIVITIES ARE COMPLETE, SHALL BE STABILIZED.
- 9.2. IN ALL AREAS, TEMPORARY SOIL STABILIZATION MEASURES SHALL BE APPLIED IN ACCORDANCE WITH THE STABILIZATION REQUIREMENTS (SECTION 2.2) OF THE 2012 CGP. (SEE TABLE 1 FOR GUIDANCE ON THE SELECTION OF TEMPORARY SOIL STABILIZATION MEASURES.)
- 9.3. EROSION CONTROL SEED MIX SHALL BE SOWN IN ALL INACTIVE CONSTRUCTION AREAS THAT WILL NOT BE PERMANENTLY SEEDED WITHIN TWO WEEKS OF DISTURBANCE AND PRIOR TO SEPTEMBER 15, OF ANY GIVEN YEAR, IN ORDER TO ACHIEVE VEGETATIVE STABILIZATION PRIOR TO THE END OF THE GROWING SEASON.
- 9.4. SOIL TACKIFIERS MAY BE APPLIED IN ACCORDANCE WITH THE MANUFACTURER'S SPECIFICATIONS AND REAPPLIED AS NECESSARY TO MINIMIZE SOIL AND MULCH LOSS UNTIL PERMANENT VEGETATION IS ESTABLISHED.
10. RETAIN SEDIMENT ON-SITE AND CONTROL DEWATERING PRACTICES:
- 10.1. TEMPORARY SEDIMENT BASINS (CGP-SECTION 2.1.3.2) OR SEDIMENT TRAPS (ENV-WO 1506.10) SHALL BE SIZED TO RETAIN, ON SITE, THE VOLUME OF A 2-YEAR 24-HOUR STORM EVENT FOR ANY AREA OF DISTURBANCE OR 3,600 CUBIC FEET OF STORMWATER RUNOFF PER ACRE OF DISTURBANCE, WHICHEVER IS GREATER. TEMPORARY SEDIMENT BASINS USED TO TREAT STORMWATER RUNOFF FROM AREAS GREATER THAN 5-ACRES OF DISTURBANCE SHALL BE SIZED TO ALSO CONTROL STORMWATER RUNOFF FROM A 10-YEAR 24 HOUR STORM EVENT. ON-SITE RETENTION OF THE 10-YEAR 24-HOUR EVENT IS NOT REQUIRED.
- 10.2. CONSTRUCT AND STABILIZE DEWATERING INFILTRATION BASINS PRIOR TO ANY EXCAVATION THAT MAY REQUIRE DEWATERING.
- 10.3. TEMPORARY SEDIMENT BASINS OR TRAPS SHALL BE PLACED AND STABILIZED AT LOCATIONS WHERE CONCENTRATED FLOW (CHANNELS AND PIPES) DISCHARGE TO THE SURROUNDING ENVIRONMENT FROM AREAS OF UNSTABILIZED EARTH DISTURBING ACTIVITIES.

11. ADDITIONAL EROSION AND SEDIMENT CONTROL GENERAL PRACTICES:
- 11.1. USE TEMPORARY MULCHING, PERMANENT MULCHING, TEMPORARY VEGETATIVE COVER, AND PERMANENT VEGETATIVE COVER TO REDUCE THE NEED FOR DUST CONTROL. USE MECHANICAL SWEEPERS ON PAVED SURFACES WHERE NECESSARY TO PREVENT DUST BUILDUP. APPLY WATER, OR OTHER DUST INHIBITING AGENTS OR TACKIFIERS, AS APPROVED BY THE NHDES.
- 11.2. ALL STOCKPILES SHALL BE CONTAINED WITH TEMPORARY PERIMETER CONTROLS. INACTIVE SOIL STOCKPILES SHOULD BE PROTECTED WITH SOIL STABILIZATION MEASURES (TEMPORARY EROSION CONTROL SEED MIX AND MULCH, SOIL BINDER) OR COVERED WITH ANCHORED TARPS.
- 11.3. EROSION AND SEDIMENT CONTROL MEASURES WILL BE INSPECTED IN ACCORDANCE WITH SECTION 645 OF NHDOT SPECIFICATIONS, WEEKLY AND WITHIN 24 HOURS AFTER ANY STORM EVENT GREATER THAN 0.25 IN. OF RAIN PER 24-HOUR PERIOD. EROSION AND SEDIMENT CONTROL MEASURES WILL ALSO BE INSPECTED IN ACCORDANCE WITH THE GUIDANCE MEMO FROM THE NHDES CONTAINED WITHIN THE CONTRACT PROPOSAL AND THE EPA CONSTRUCTION GENERAL PERMIT.
- 11.4. THE CONTRACTOR SHOULD UTILIZE STORM DRAIN INLET PROTECTION TO PREVENT SEDIMENT FROM ENTERING A STORM DRAINAGE SYSTEM PRIOR TO THE PERMANENT STABILIZATION OF THE CONTRIBUTING DISTURBED AREA.
- 11.5. PERMANENT STABILIZATION MEASURES WILL BE CONSTRUCTED AND MAINTAINED IN LOCATIONS AS SHOWN ON THE CONSTRUCTION PLANS TO STABILIZE AREAS. VEGETATIVE STABILIZATION SHALL NOT BE CONSIDERED PERMANENTLY STABILIZED UNTIL VEGETATIVE GROWTH COVERS AT LEAST 85% OF THE DISTURBED AREA. THE CONTRACTOR SHALL BE RESPONSIBLE FOR EROSION AND SEDIMENT CONTROL FOR ONE YEAR AFTER PROJECT COMPLETION.
- 11.6. CATCH BASINS: CARE SHALL BE TAKEN TO ENSURE THAT SEDIMENTS DO NOT ENTER ANY EXISTING CATCH BASINS DURING CONSTRUCTION. THE CONTRACTOR SHALL PLACE TEMPORARY STONE INLET PROTECTION OVER INLETS IN AREAS OF SOIL DISTURBANCE THAT ARE SUBJECT TO SEDIMENT CONTAMINATION.
- 11.7. TEMPORARY AND PERMANENT DITCHES SHALL BE CONSTRUCTED, STABILIZED AND MAINTAINED IN A MANNER THAT WILL MINIMIZE SCOUR. TEMPORARY AND PERMANENT DITCHES SHALL BE DIRECTED TO DRAIN TO SEDIMENT BASINS OR STORM WATER COLLECTION AREAS.
- 11.8. WINTER EXCAVATION AND EARTHWORK ACTIVITIES NEED TO BE LIMITED IN EXTENT AND DURATION, TO MINIMIZE POTENTIAL EROSION AND SEDIMENTATION IMPACTS. THE AREA OF EXPOSED SOIL SHALL BE LIMITED TO ONE ACRE, OR THAT WHICH CAN BE STABILIZED AT THE END OF EACH DAY UNLESS A WINTER CONSTRUCTION PLAN, DEVELOPED BY A QUALIFIED ENGINEER OR A CPESC SPECIALIST, IS REVIEWED AND APPROVED BY THE DEPARTMENT.
- 11.9. CHANNEL PROTECTION MEASURES SHALL BE SUPPLEMENTED WITH PERIMETER CONTROL MEASURES WHEN THE DITCH LINES OCCUR AT THE BOTTOM OF LONG FILL SLOPES. THE PERIMETER CONTROLS SHALL BE INSTALLED ON THE FILL SLOPE TO MINIMIZE THE POTENTIAL FOR FILL SLOPE SEDIMENT DEPOSITS IN THE DITCH LINE.

BEST MANAGEMENT PRACTICES (BMP) BASED ON AMOUNT OF OPEN CONSTRUCTION AREA

12. STRATEGIES SPECIFIC TO OPEN AREAS LESS THAN 5 ACRES:
- 12.1. THE CONTRACTOR SHALL COMPLY WITH RSA 485-A:17 AND ENV-WO 1500: ALTERATION OF TERRAIN FOR CONSTRUCTION AND USE ALL CONVENTIONAL BMP STRATEGIES.
- 12.2. SLOPES STEEPER THAN 3:1 WILL RECEIVE TURF ESTABLISHMENT WITH MATTING.
- 12.3. SLOPES 3:1 OR FLATTER WILL RECEIVE TURF ESTABLISHMENT ALONE.
- 12.4. AREAS WHERE HAUL ROADS ARE CONSTRUCTED AND STORMWATER CANNOT BE TREATED THE DEPARTMENT WILL CONSIDER INFILTRATION.
- 12.5. FOR HAUL ROADS ADJACENT TO SENSITIVE ENVIRONMENTAL AREAS OR STEEPER THAN 5%, THE DEPARTMENT WILL CONSIDER USING EROSION STONE, CRUSHED GRAVEL, OR CRUSHED STONE BASE TO HELP MINIMIZE EROSION ISSUES.
- 12.6. ALL AREAS THAT CAN BE STABILIZED SHALL BE STABILIZED PRIOR TO OPENING UP NEW TERRITORY.
- 12.7. DETENTION BASINS SHALL BE DESIGNED AND CONSTRUCTED TO ACCOMMODATE A 2 YEAR STORM EVENT.
13. STRATEGIES SPECIFIC TO OPEN AREAS BETWEEN 5 AND 10 ACRES:
- 13.1. THE CONTRACTOR SHALL COMPLY WITH RSA 485-A:17 AND ENV-WO 1500 ALTERATION OF TERRAIN AND SHALL USE CONVENTIONAL BMP STRATEGIES AND ALL TREATMENT OPTIONS USED FOR UNDER 5 ACRES WILL BE UTILIZED.
- 13.2. DETENTION BASINS WILL BE CONSTRUCTED TO ACCOMMODATE THE 2-YEAR 24-HOUR STORM EVENT AND CONTROL A 10-YEAR 24-HOUR STORM EVENT.
- 13.3. SLOPES STEEPER THAN A 3:1 WILL RECEIVE TURF ESTABLISHMENT WITH MATTING OR OTHER TEMPORARY SOIL STABILIZATION MEASURES DETAILED IN TABLE 1. THE CONTRACTOR MAY ALSO CONSIDER A SOIL BINDER IN ACCORDANCE WITH THE NHDES APPROVALS OR REGULATIONS. OTHER ALTERNATIVE MEASURES, SUCH AS BONDED FIBER MATRICES (BFMS) OR FLEXIBLE GROWTH MEDIUMS (FGMS) MAY BE UTILIZED, IF MEETING THE NHDES APPROVALS AND REGULATIONS.
- 13.4. SLOPES 3:1 OR FLATTER WILL RECEIVE TURF ESTABLISHMENT OR OTHER TEMPORARY SOIL STABILIZATION MEASURES DETAILED IN TABLE 1. THE CONTRACTOR MAY ALSO CONSIDER A SOIL BINDER IN ACCORDANCE WITH THE NHDES APPROVALS OR REGULATIONS.
14. STRATEGIES SPECIFIC TO OPEN AREAS OVER 10 ACRES:
- 14.1. THE CONTRACTOR SHALL COMPLY WITH RSA 485-A:17 AND ENV-WO 1500 ALTERATION OF TERRAIN AND SHALL USE CONVENTIONAL BMP STRATEGIES AND ALL TREATMENT OPTIONS USED FOR UNDER 5 ACRES AND BETWEEN 5 AND 10 ACRES WILL BE UTILIZED.
- 14.2. THE DEPARTMENT ANTICIPATES THAT SOIL BINDERS WILL BE NEEDED ON ALL SLOPES STEEPER THAN 3:1, IN ORDER TO MINIMIZE EROSION AND REDUCE THE AMOUNT OF SEDIMENT IN THE STORMWATER TREATMENT BASINS.
- 14.3. THE CONTRACTOR WILL BE REQUIRED TO HAVE AN APPROVED DESIGN IN ACCORDANCE WITH ENV-WO 1506.12 FOR AN ACTIVE FLOCCULANT TREATMENT SYSTEM TO TREAT AND RELEASE WATER CAPTURED IN STORM WATER BASINS. THE CONTRACTOR SHALL ALSO RETAIN THE SERVICES OF AN ENVIRONMENTAL CONSULTANT WHO HAS DEMONSTRATED EXPERIENCE IN THE DESIGN OF FLOCCULANT TREATMENT SYSTEMS. THE CONSULTANT WILL ALSO BE RESPONSIBLE FOR THE IMPLEMENTATION AND MONITORING OF THE SYSTEM.

TABLE 1
GUIDANCE ON SELECTING TEMPORARY SOIL STABILIZATION MEASURES

| APPLICATION AREAS | DRY MULCH METHODS | | | | HYDRAULICALLY APPLIED MULCHES ² | | | | ROLLED EROSION CONTROL BLANKETS ³ | | | |
|----------------------|-------------------|------------------|-----|-----|--------------------------------------------|-----|-----|-----|----------------------------------------------|------|-------|------|
| | HMT | WC | SG | CB | HM | SMM | BFM | FRM | SNSB | DNSB | DNSCB | DNCB |
| SLOPES ¹ | | | | | | | | | | | | |
| Steeper than 2:1 | NO | NO | YES | NO | NO | NO | NO | YES | NO | NO | NO | YES |
| 2:1 Slope | YES ¹ | YES ¹ | YES | YES | NO | NO | YES | YES | NO | YES | YES | YES |
| 3:1 Slope | YES | YES | YES | YES | NO | YES | YES | YES | YES | YES | YES | NO |
| 4:1 Slope | YES | YES | YES | YES | YES | YES | YES | YES | YES | YES | NO | NO |
| Winter Stabilization | 4T/AC | YES | YES | YES | NO | NO | YES | YES | YES | YES | YES | YES |
| CHANNELS | | | | | | | | | | | | |
| Low Flow Channels | NO | NO | NO | NO | NO | NO | NO | NO | NO | NO | YES | YES |
| High Flow Channels | NO | NO | NO | NO | NO | NO | NO | NO | NO | NO | NO | YES |

| ABBREV. | STABILIZATION MEASURE | ABBREV. | STABILIZATION MEASURE | ABBREV. | STABILIZATION MEASURE |
|---------|-----------------------|---------|-------------------------|---------|-----------------------------|
| HMT | HAY MULCH & TACK | HM | HYDRAULIC MULCH | SNSB | SINGLE NET STRAW BLANKET |
| WC | WOOD CHIPS | SMM | STABILIZED MULCH MATRIX | DNSB | DOUBLE NET STRAW BLANKET |
| SG | STUMP GRINDINGS | BFM | BONDED FIBER MATRIX | DNSCB | 2 NET STRAW-COCONUT BLANKET |
| CB | COMPOST BLANKET | FRM | FIBER REINFORCED MEDIUM | DNCB | 2 NET COCONUT BLANKET |

- NOTES:
1. ALL SLOPE STABILIZATION OPTIONS ASSUME A SLOPE LENGTH \leq 10 TIMES THE HORIZONTAL DISTANCE COMPONENT OF THE SLOPE, IN FEET.
2. PRODUCTS CONTAINING POLYACRYLAMIDE (PAM) SHALL NOT BE APPLIED DIRECTLY TO OR WITHIN 100 FEET OF ANY SURFACE WATER WITHOUT PRIOR WRITTEN APPROVAL FROM THE NH DEPARTMENT OF ENVIRONMENTAL SERVICES.
3. ALL EROSION CONTROL BLANKETS SHALL BE MADE WITH WILDLIFE FRIENDLY BIODEGRADABLE NETTING.

REVISED NOV. 3, 2016

| | | | | |
|---------------------------------------------------------|-----------|-------------------|-----------|--------------|
| STATE OF NEW HAMPSHIRE | | | | |
| DEPARTMENT OF TRANSPORTATION • BUREAU OF HIGHWAY DESIGN | | | | |
| WETLAND IMPACT PLANS | | | | |
| REVISION DATE | DGN | STATE PROJECT NO. | SHEET NO. | TOTAL SHEETS |
| 12-21-2015 | erosstrat | 13953 | 4 | 25 |

| WETLAND IMPACT SUMMARY | | | | | | | | | | |
|------------------------|---------------------------|----------|---------------------------|-------------------------------------|----------------------|---------------------------------|------------------------------|---------------------------------|------------------------------|----|
| WETLAND DESIGNATION | WETLAND CLASSIFICATION | LOCATION | AREA | | | LINEAR FEET OF IMPACTS | | | | |
| | | | PERMANENT IMPACTS | | TEMPORARY IMPACTS | PERMANENT IMPACTS CHANNEL | PERMANENT IMPACTS BANK | TEMPORARY IMPACTS CHANNEL | TEMPORARY IMPACTS BANK | |
| | | | N.H.W.B. (NON-WETLAND) | N.H.W.B. & A.C.O.E. (WETLAND) | | | | | | |
| | | | SF | | | | | | | SF |
| 3A | BANK | A | 6922 | | | | | 373 | | |
| 3B | BANK | G | 3178 | | | | | 169 | | |
| 7 | R2UB3 | D | | | 1095 | | | | 42 | |
| 7 | R2UB3 | H | | 217 | | 27 | | | | |
| 7C | BANK | D1 | 708 | | | | 41 | | | |
| 8 | PEM1 | B | | | 458 | | | | | |
| 8 | PEM1 | C | | 1083 | | | | | | |
| 11 | PEM1 | E | | | 1805 | | | | | |
| 11 | PEM1 | F | | 2840 | | | | | | |
| 12 | PSS1 | I | | 102 | | | | | | |
| 13 | R2UB3 | M | | 121 | | 21 | | | | |
| 13 | R2UB3 | N | | | 123 | | | 31 | | |
| 13A | BANK | L | 377 | | | | 50 | | | |
| 13A | BANK | O | | | 364 | | | | | 36 |
| 14 | R2UB3 | K | | 1609 | | 155 | | | | |
| 14A | BANK | J | 3786 | | | | 259 | | | |
| 15 | PSS1 | P | | | 2371 | | | | | |
| 15 | PSS1 | Q | | 7616 | | | | | | |
| 16 | PFO1 | R | | | 201 | | | | | |
| 16 | PFO1 | T | | 2343 | | | | | | |
| 17 | PSS1 | S | | 6761 | | | | | | |
| 17 | PSS1 | U | | | 2491 | | | | | |
| 18 | PEM1 | V | | | 280 | | | | | |
| 18 | PEM1 | W | | 1884 | | | | | | |
| 19 | PEM1 | Z | | 3554 | | | | | | |
| 20 | PFO1 | AA | | | 1026 | | | | | |
| 20 | PFO1 | AB | | 4139 | | | | | | |
| 21 | PEM1 | X | | 1309 | | | | | | |
| 21 | PEM1 | Y | | | 1209 | | | | | |
| 23 | PEM1 | AE | | | 628 | | | | | |
| 23 | PEM1 | AC | | 1077 | | | | | | |
| 23 | PEM1 | AD | | | 477 | | | | | |
| 24 | PFO1 | AF | | 10174 | | | | | | |
| 24 | PFO1 | AG | | | 2002 | | | | | |
| 25 | PSS1 | AH | | 1324 | | | | | | |
| 25 | PSS1 | AI | | | 640 | | | | | |
| 26 | PEM1 | AJ | | 350 | | | | | | |
| 27 | PEM1 | AK | | 3068 | | | | | | |
| 28 | PEM1 | AL | | 12151 | | | | | | |
| 28 | PEM1 | AM | | | 3237 | | | | | |
| 29 | PFO1 | AO | | 276 | | | | | | |
| 29 | PFO1 | AN | | | 183 | | | | | |
| 30 | PSS1 | AP | | | 233 | | | | | |
| 30 | PSS1 | AQ | | 325 | | | | | | |
| 31 | PEM1 | AR | | 3243 | | | | | | |
| 31 | PEM1 | AS | | | 516 | | | | | |
| 35 | PEM1 | AW | | 10124 | | | | | | |
| 35 | PEM1 | AX | | | 1002 | | | | | |
| 36 | PFO1 | AT | | 5231 | | | | | | |
| 36 | PFO1 | AT1 | | 1022 | | | | | | |
| 36 | PFO1 | AZ | | | 1898 | | | | | |
| 36 | PFO1 | AZ1 | | | 433 | | | | | |
| 37 | PEM1 | AU | | 25661 | | | | | | |
| 37 | PEM1 | AV | | | 7891 | | | | | |
| 39 | PEM1 | AY | | 4514 | | | | | | |

| WETLAND IMPACT SUMMARY | | | | | | | | | |
|------------------------|------------------------|----------|------------------------|-------------------------------|-------------------|---------------------------|------------------------|---------------------------|------------------------|
| WETLAND DESIGNATION | WETLAND CLASSIFICATION | LOCATION | AREA | | | LINEAR FEET OF IMPACTS | | | |
| | | | PERMANENT IMPACTS | | TEMPORARY IMPACTS | PERMANENT IMPACTS CHANNEL | PERMANENT IMPACTS BANK | TEMPORARY IMPACTS CHANNEL | TEMPORARY IMPACTS BANK |
| | | | N.H.W.B. (NON-WETLAND) | N.H.W.B. & A.C.O.E. (WETLAND) | | | | | |
| | | | SF | SF | | | | | |
| 40 | PSS1 | BA | | 5944 | | | | | |
| 40 | PSS1 | BB | | | 4139 | | | | |
| 41 | PEM1 | BC | | 5421 | | | | | |
| 41 | PEM1 | BD | | | 3016 | | | | |
| 42 | PUB3 | BG | | | 628 | | | | |
| 42 | PUB3 | BH | | 1248 | | | | | |
| 43 | PAB4 | BE | | 1392 | | | | | |
| 43 | PAB4 | BF | | | 1088 | | | | |
| 44 | PFO1 | BI | | 982 | | | | | |
| 44 | PFO1 | BJ | | | 595 | | | | |
| 45 | PEM1 | BL | | 1554 | | | | | |
| 45 | PEM1 | BM | | | 457 | | | | |
| 47 | PUB3 | BP | | 1473 | | | | | |
| 48 | PSS1 | BN | | 1542 | | | | | |
| 48 | PSS1 | BO | | | 1845 | | | | |
| 50 | PEM1 | BQ | | 1180 | | | | | |
| 51 | PEM1 | BR | | 237 | | | | | |
| 52 | PEM1 | BU | | 1674 | | | | | |
| 52 | PEM1 | BV | | | 990 | | | | |
| 53 | PFO1 | BS | | | 2003 | | | | |
| 53 | PFO1 | BW | | 3213 | | | | | |
| 54 | PEM1 | BZ | | 14300 | | | | | |
| 54 | R2UB3 | BZ1 | | 3991 | | 518 | 460 | | |
| 54 | BANK | BZ2 | 1429 | | | | 410 | | |
| 54 | PEM1 | CA | | | 6922 | | | 44 | |
| 55 | PEM1 | BX | | 1751 | | | | | |
| 55 | PEM1 | BY | | | 2780 | | | | |
| 56 | PEM1 | CB | | 467 | | | | | |
| 57 | PFO1 | CC | | 192 | | | | | |
| 57 | R2UB3 | CC1 | | 247 | | 26 | 22 | | |
| 57 | BANK | CC2 | 135 | | | | 25 | | |
| 57 | PFO1 | CD | | | 348 | | | | |
| 57 | R2UB3 | CD1 | | | 202 | | | 27 | 70 |
| 58 | R2UB3 | CG | | 194 | | 27 | | | |
| 58 | BANK | CG1 | 164 | | | | 50 | | |
| 58 | R2UB3 | CH | | | 34 | | | 5 | |
| 58A | BANK | CI | | | 805 | | | | 58 |
| 58A | BANK | CJ | 2471 | | | | 140 | | |
| 59 | PFO1 | CE | | 135 | | | | | |
| 60A | BANK | CK | 319 | | | | 47 | | |
| 65 | PEM1 | BK | | 391 | | | | | |

| WETLAND CLASSIFICATION CODES | |
|------------------------------|----------------------------------------------------------------|
| PAB4 | PALUSTRINE AQUATIC BED, FLOATING VASCULAR |
| PEM1 | PALUSTRINE EMERGENT, PERSISTENT |
| PFO1 | PALUSTRINE FORESTED WETLAND, BROAD-LEAVED DECIDUOUS |
| PSS1 | PALUSTRINE SCRUB-SHRUB SWAMP, BROAD-LEAVED DECIDUOUS |
| PUB3 | PALUSTRINE UNCONSOLIDATED BOTTOM, MUD |
| R2UB3 | RIVERINE LOWER PERENNIAL, UNCONSOLIDATED BOTTOM, COBBLE/GRAVEL |
| R4SB5 | RIVERINE INTERMITTENT STREAMBED, MUD |

Permanent Impacts: 179135 SF
Temporary Impacts: 56416 SF

Total Impacts: 235551 SF

Channel Permanent Impacts: 774 LF
Bank Permanent Impacts: 2046 LF
Channel Temporary Impacts: 149 LF
Bank Temporary Impacts: 164 LF

Total Impacts: 3133 LF




Louis Berger
Manchester, New Hampshire
(603) 644-5200

LEGEND


- PERMANENT N.H.W.B. & A.C.O.E. (WETLAND)
- PERMANENT N.H.W.B. (NON-WETLAND)
- TEMPORARY IMPACTS

REVISED NOV. 3, 2016

| STATE OF NEW HAMPSHIRE | | | |
|---------------------------------------------------------|-------------------|-----------|--------------|
| DEPARTMENT OF TRANSPORTATION • BUREAU OF HIGHWAY DESIGN | | | |
| WETLAND IMPACT SUMMARY AND CLASSIFICATION TABLE | | | |
| DGN | STATE PROJECT NO. | SHEET NO. | TOTAL SHEETS |
| WETTABLE 01 | 13953 | 5 | 25 |

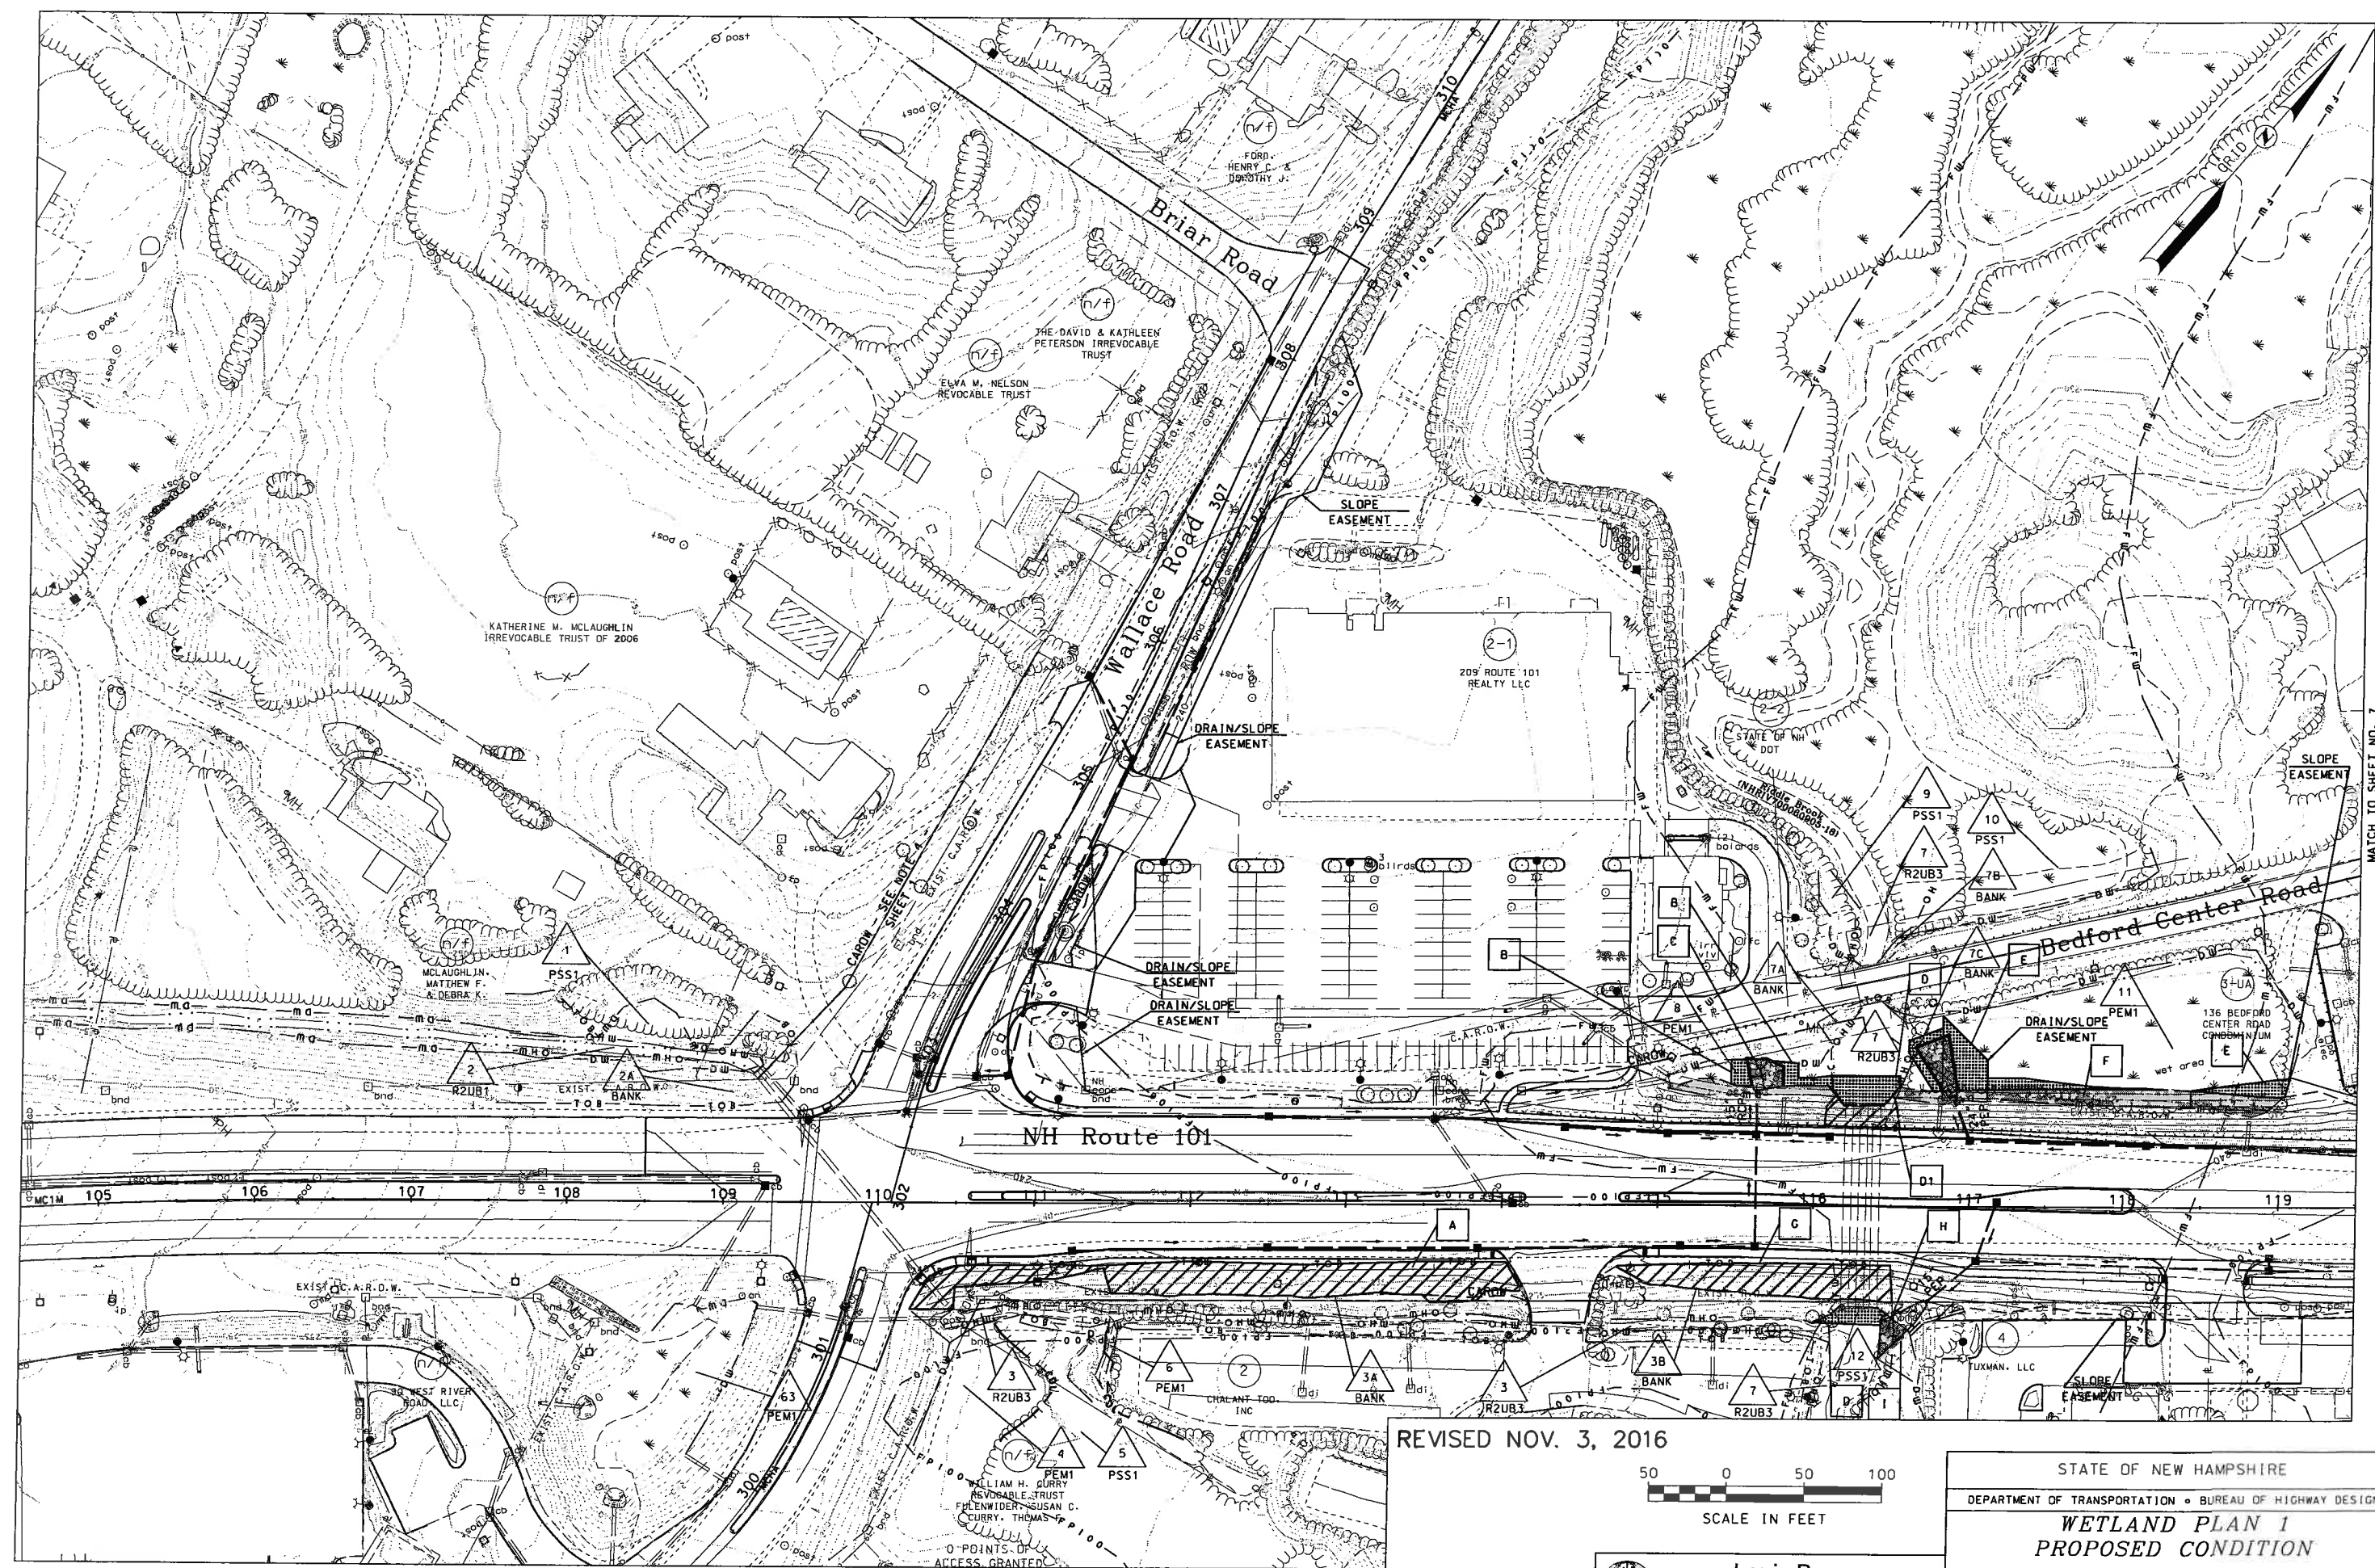[illegible]


REVISÉ NOV. 3, 2016

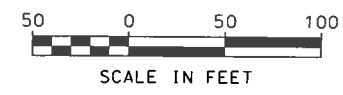

 **Louis Berger**
Manchester, New Hampshire
(603) 644 5200

| | | | |
|----------------------------------------------------------------------------|-------------------|-----------|--------------|
| STATE OF NEW HAMPSHIRE | | | |
| DEPARTMENT OF TRANSPORTATION • BUREAU OF HIGHWAY DESIGN | | | |
| <p align="center">WETLAND PLAN 1 PROPOSED CONDITION</p> | | | |
| DCN | STATE PROJECT NO. | SHEET NO. | TOTAL SHEETS |
| WETPLANS 01 | 13953 | 6 | 25 |

| SDR PROCESSED | | REVISIONS AFTER PROPOSAL | |
|------------------|-----|--------------------------|-------------|
| NEW DESIGN | ERW | STATION | DESCRIPTION |
| SHEET CHECKED | LSF | DATE | NUMBER |
| AS BUILT DETAILS | | DATE | NUMBER |

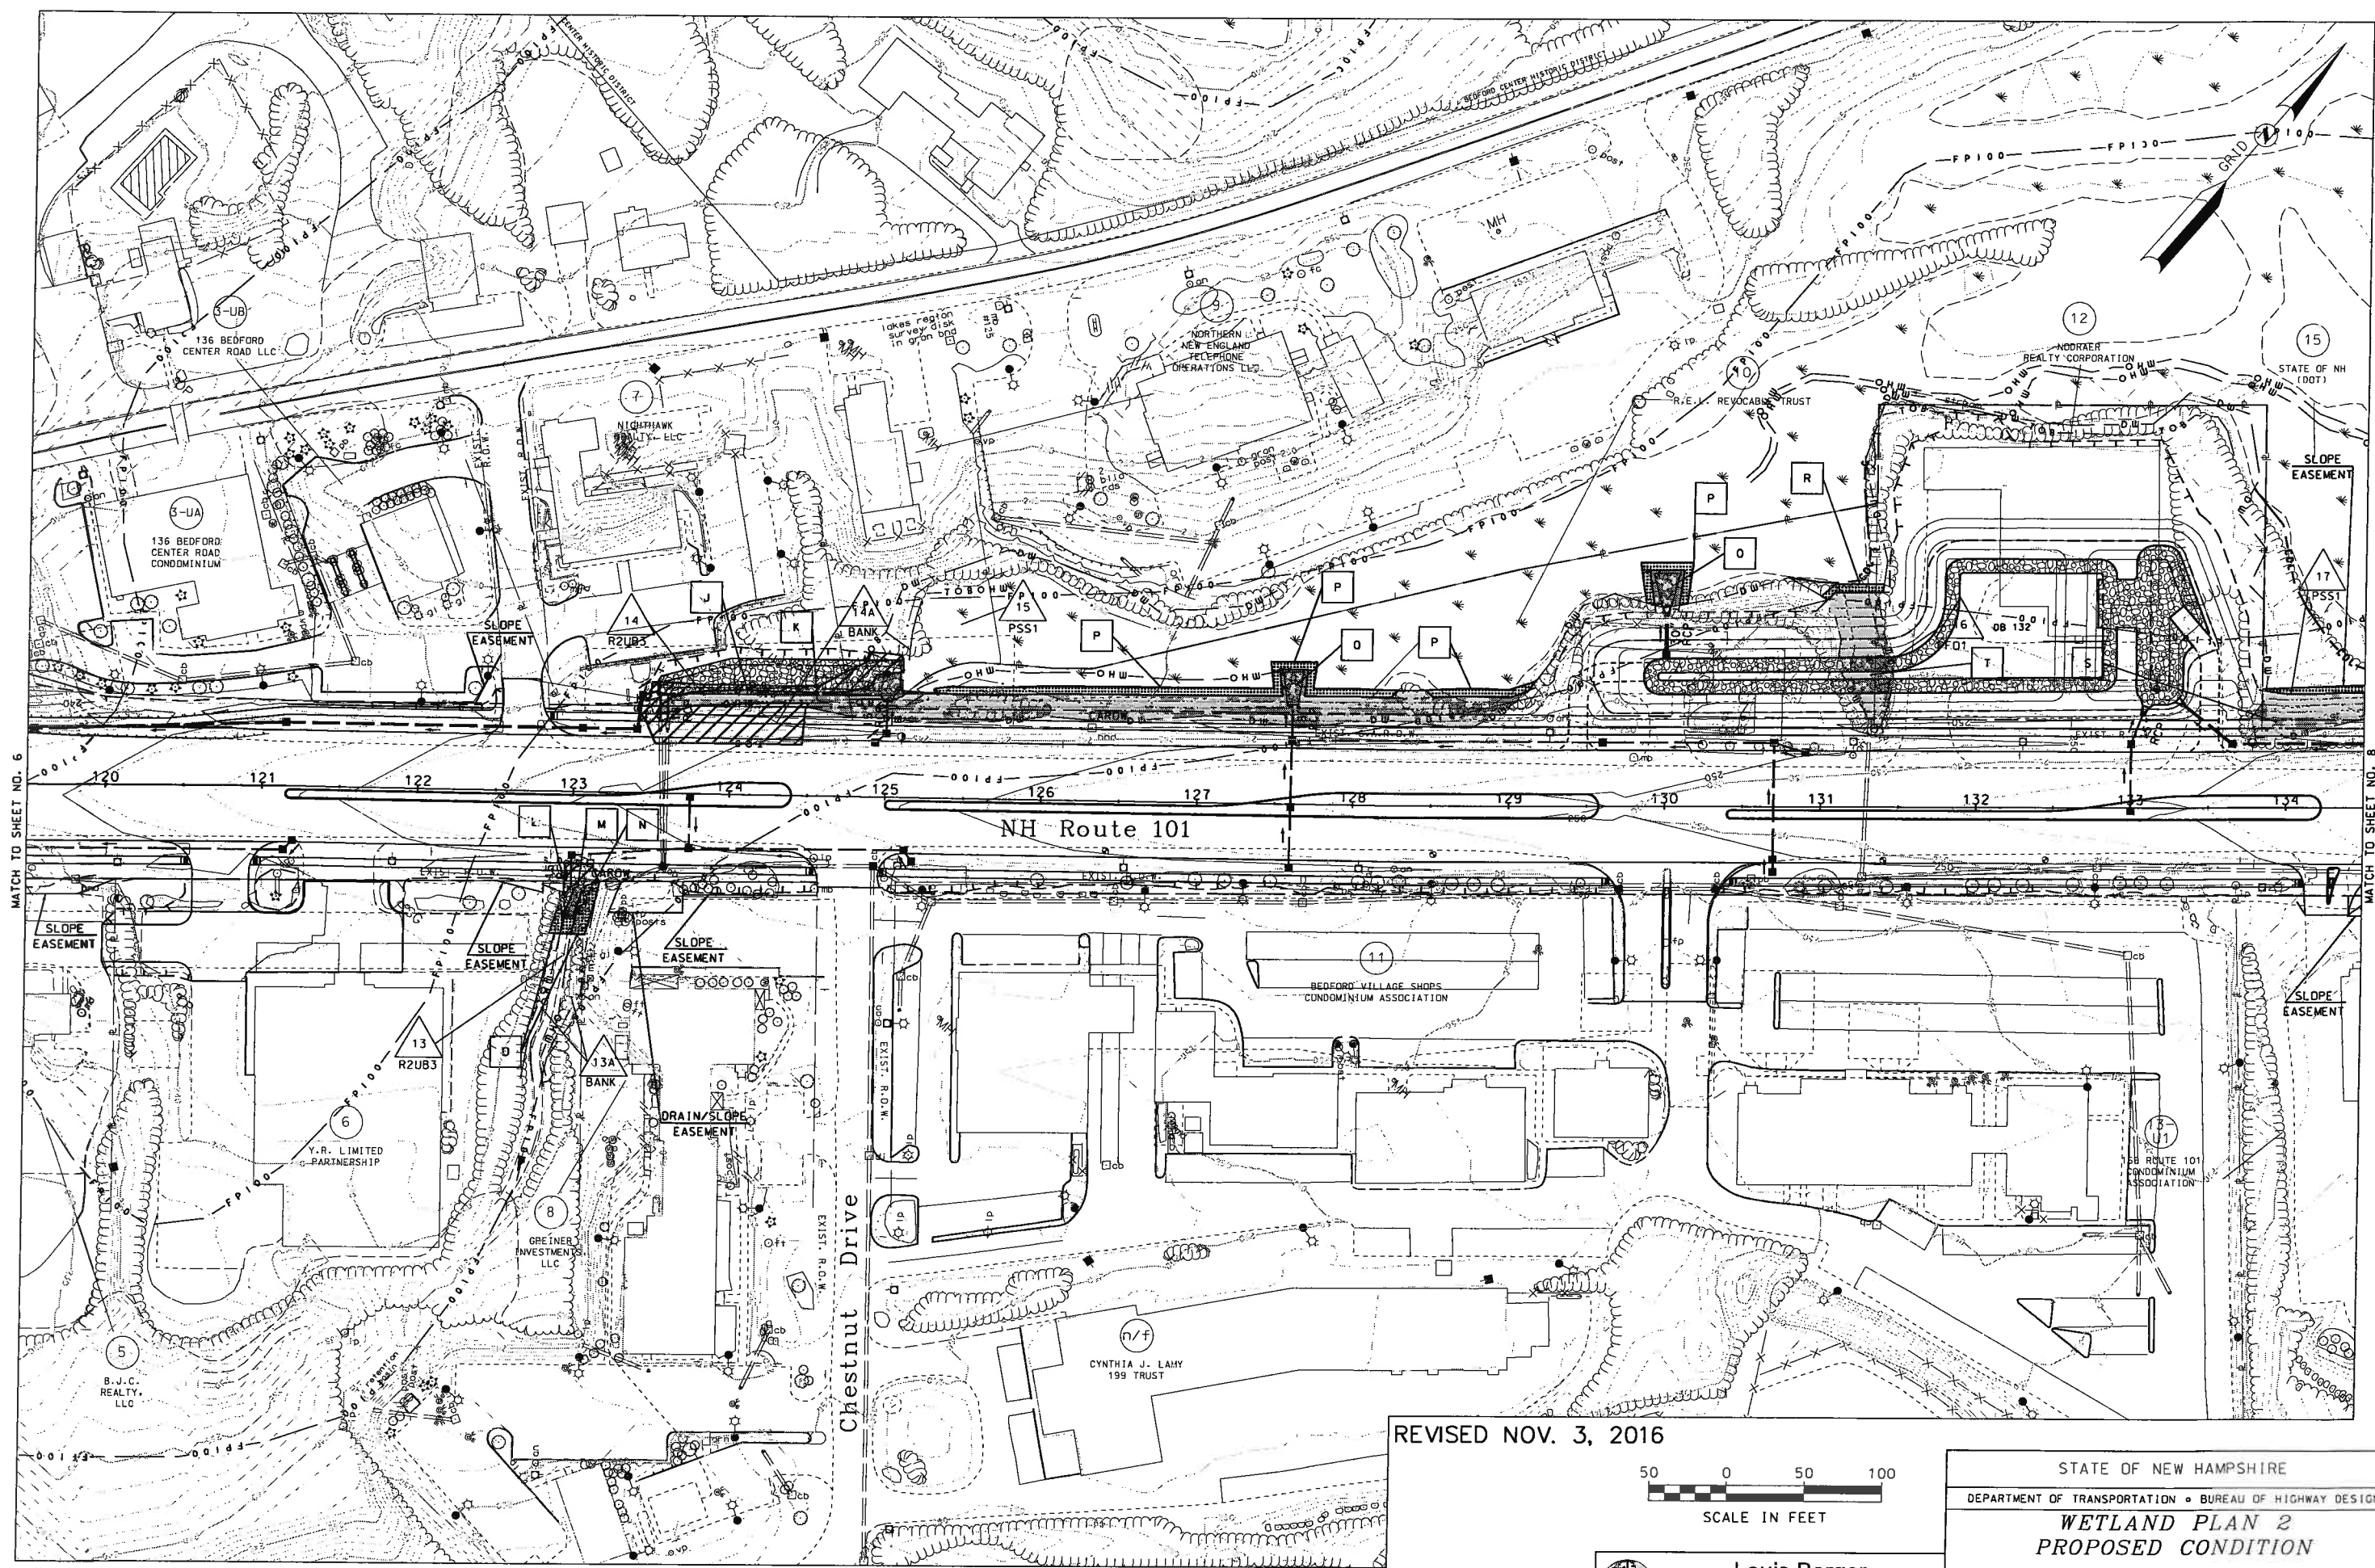


REVISED NOV. 3, 2016




Louis Berger
Manchester, New Hampshire
(603) 644 5200

| STATE OF NEW HAMPSHIRE | | | |
|---------------------------------------------------------|-------------------|-----------|--------------|
| DEPARTMENT OF TRANSPORTATION • BUREAU OF HIGHWAY DESIGN | | | |
| WETLAND PLAN 2 | | | |
| PROPOSED CONDITION | | | |
| DGN | STATE PROJECT NO. | SHEET NO. | TOTAL SHEETS |
| WETPLANS 02 | 13953 | 7 | 25 |

| REVISIONS AFTER PROPOSAL | | STATION | | DESCRIPTION | |
|--------------------------|---------------|---------|------|-------------|------|
| NUMBER | DATE | STATION | DATE | NUMBER | DATE |
| SDR PROCESSED | DATE 08/23/16 | | | | |
| NEW DESIGN | DATE 08/23/16 | | | | |
| SHEET CHECKED | DATE 08/23/16 | | | | |
| AS BUILT DETAILS | DATE | | | | |

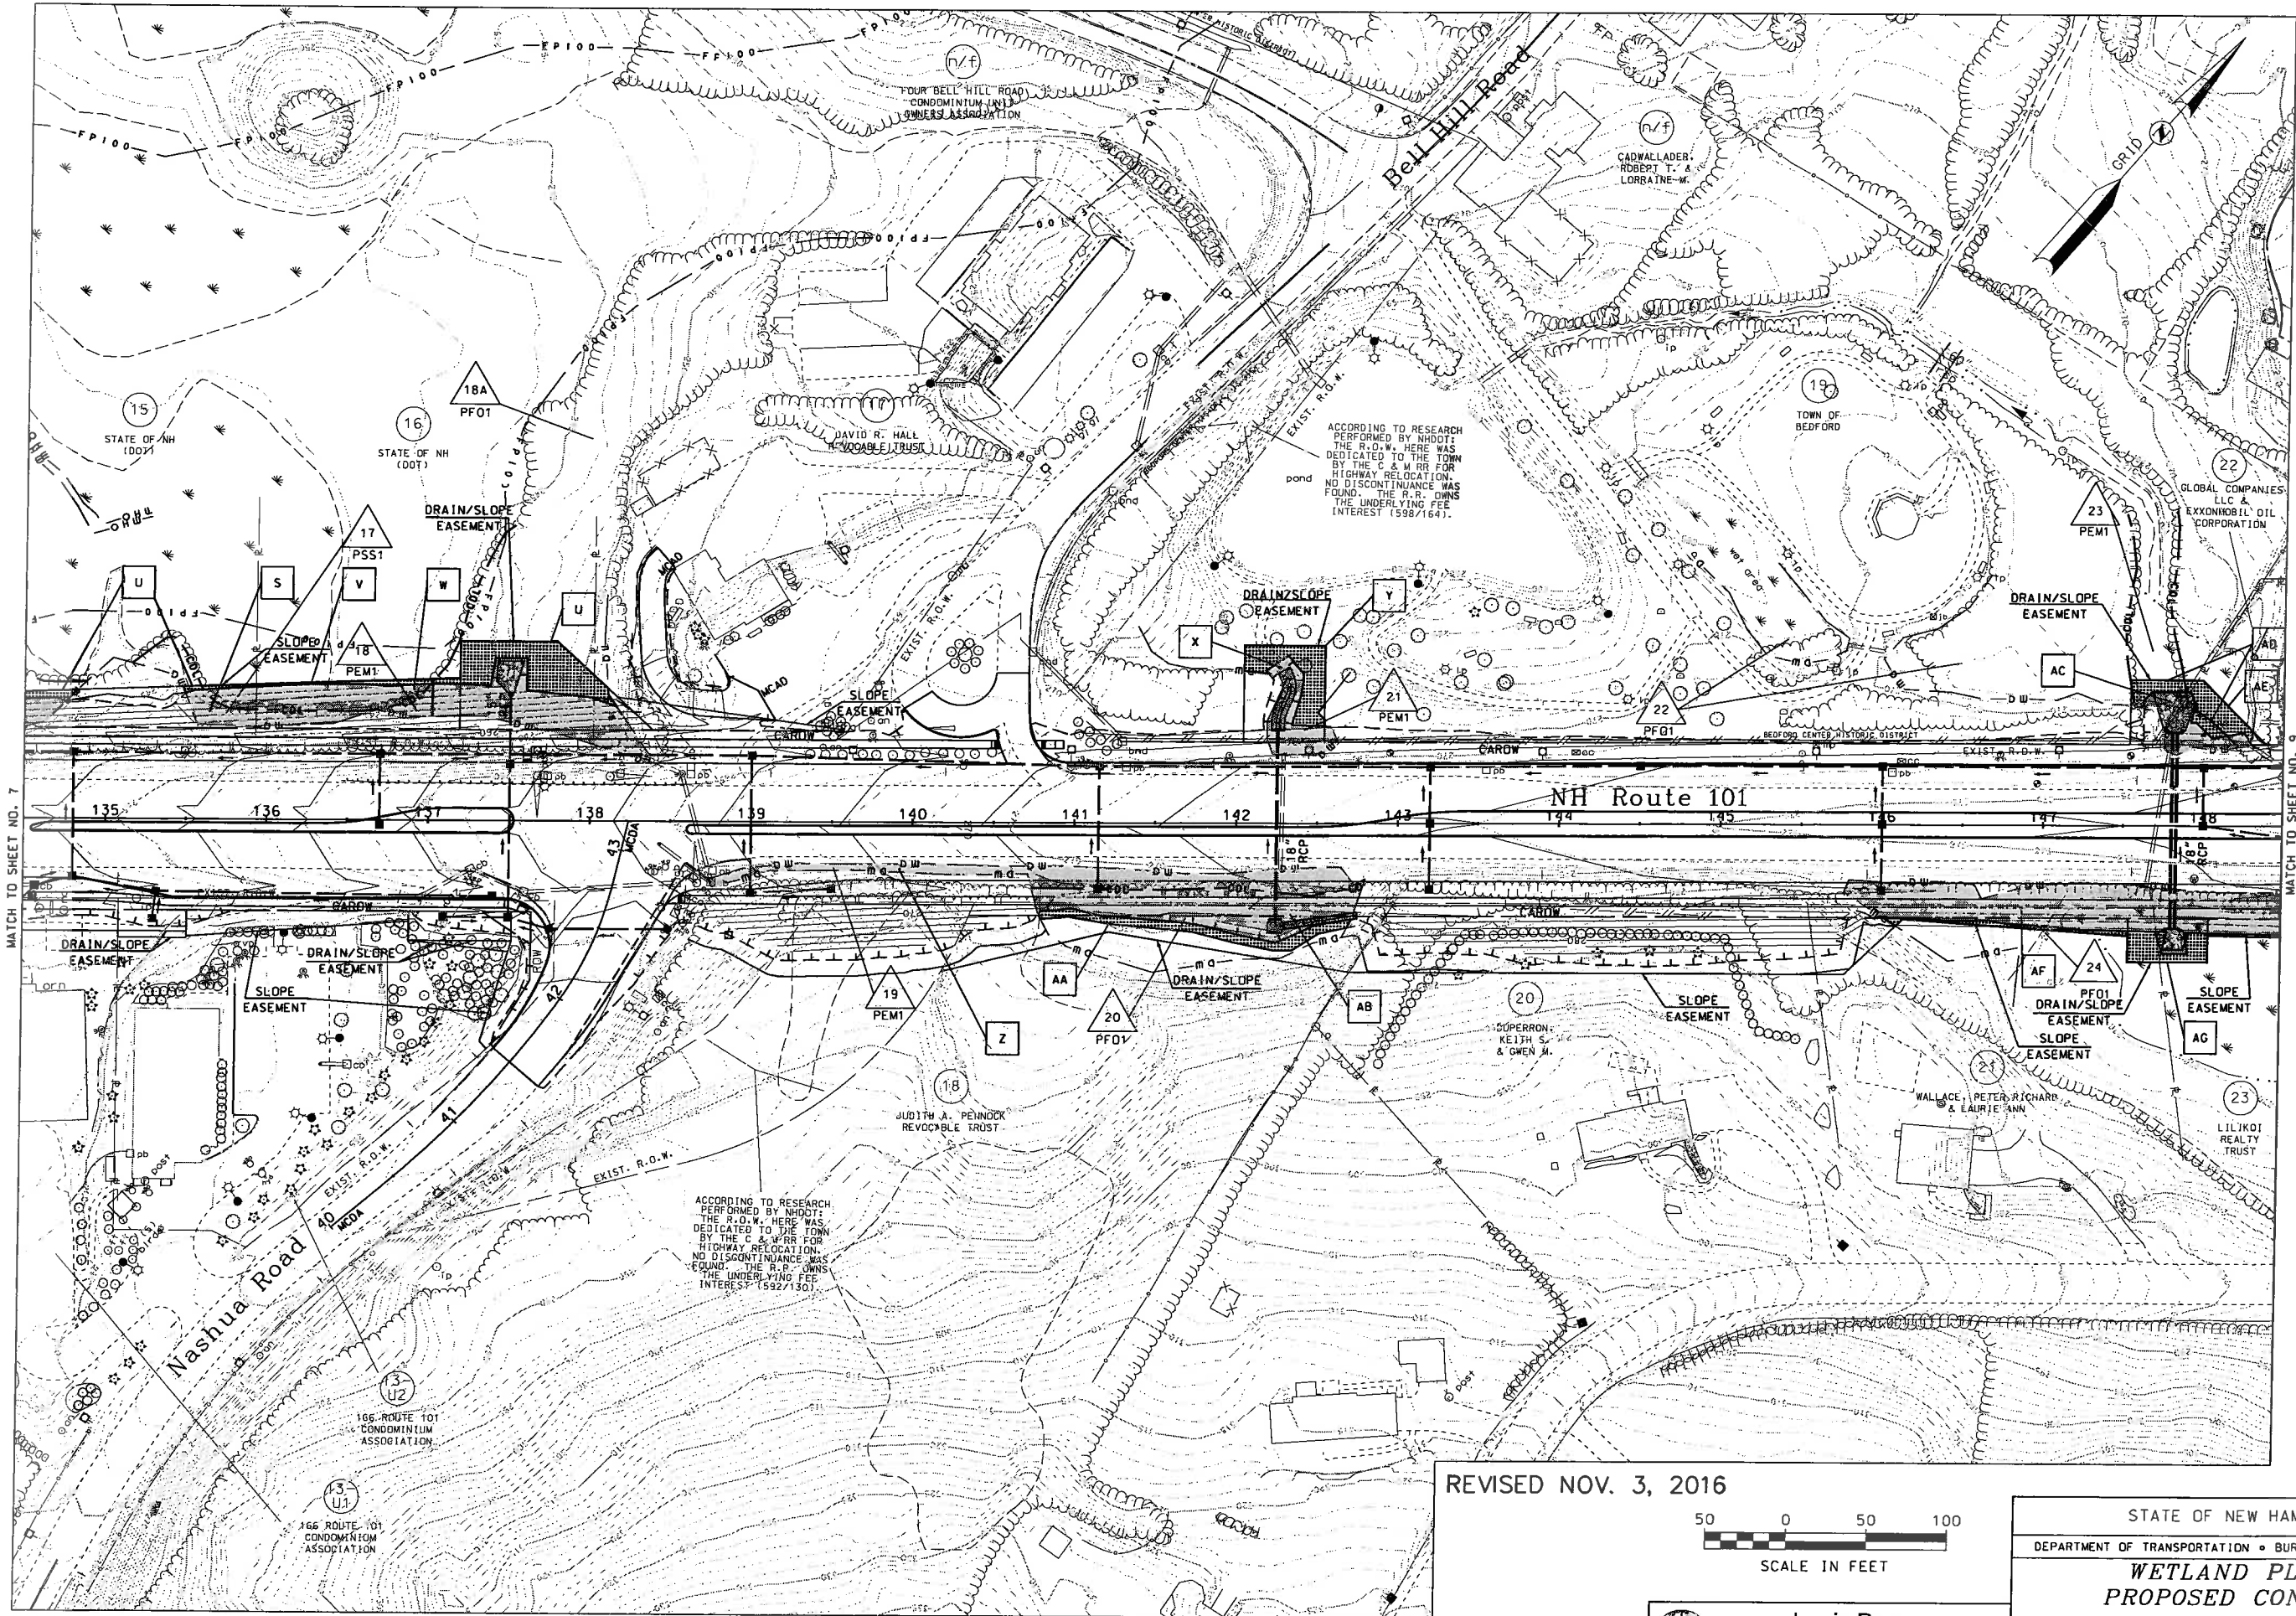



REVISED NOV. 3, 2016

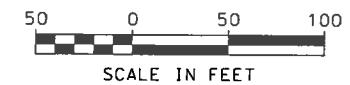

Louis Berger
Manchester, New Hampshire
(603) 644 5200


| | | | |
|---------------------------------------------------------|-------------------|-----------|--------------|
| STATE OF NEW HAMPSHIRE | | | |
| DEPARTMENT OF TRANSPORTATION • BUREAU OF HIGHWAY DESIGN | | | |
| WETLAND PLAN 3 | | | |
| PROPOSED CONDITION | | | |
| DCM | STATE PROJECT NO. | SHEET NO. | TOTAL SHEETS |
| WETPLANS 03 | 13953 | 8 | 25 |

| SDR PROCESSED | | REVISIONS AFTER PROPOSAL | | STATION | | DESCRIPTION | |
|------------------|-----|--------------------------|--------|---------------|---------|-------------|---------|
| NEW DESIGN | ERW | DATE | NUMBER | DATE | STATION | DATE | STATION |
| SHEET CHECKED | LSF | DATE 08/23/16 | | DATE 08/23/16 | | | |
| AS BUILT DETAILS | | DATE | | | | | |

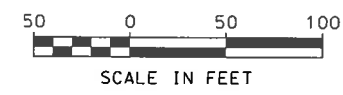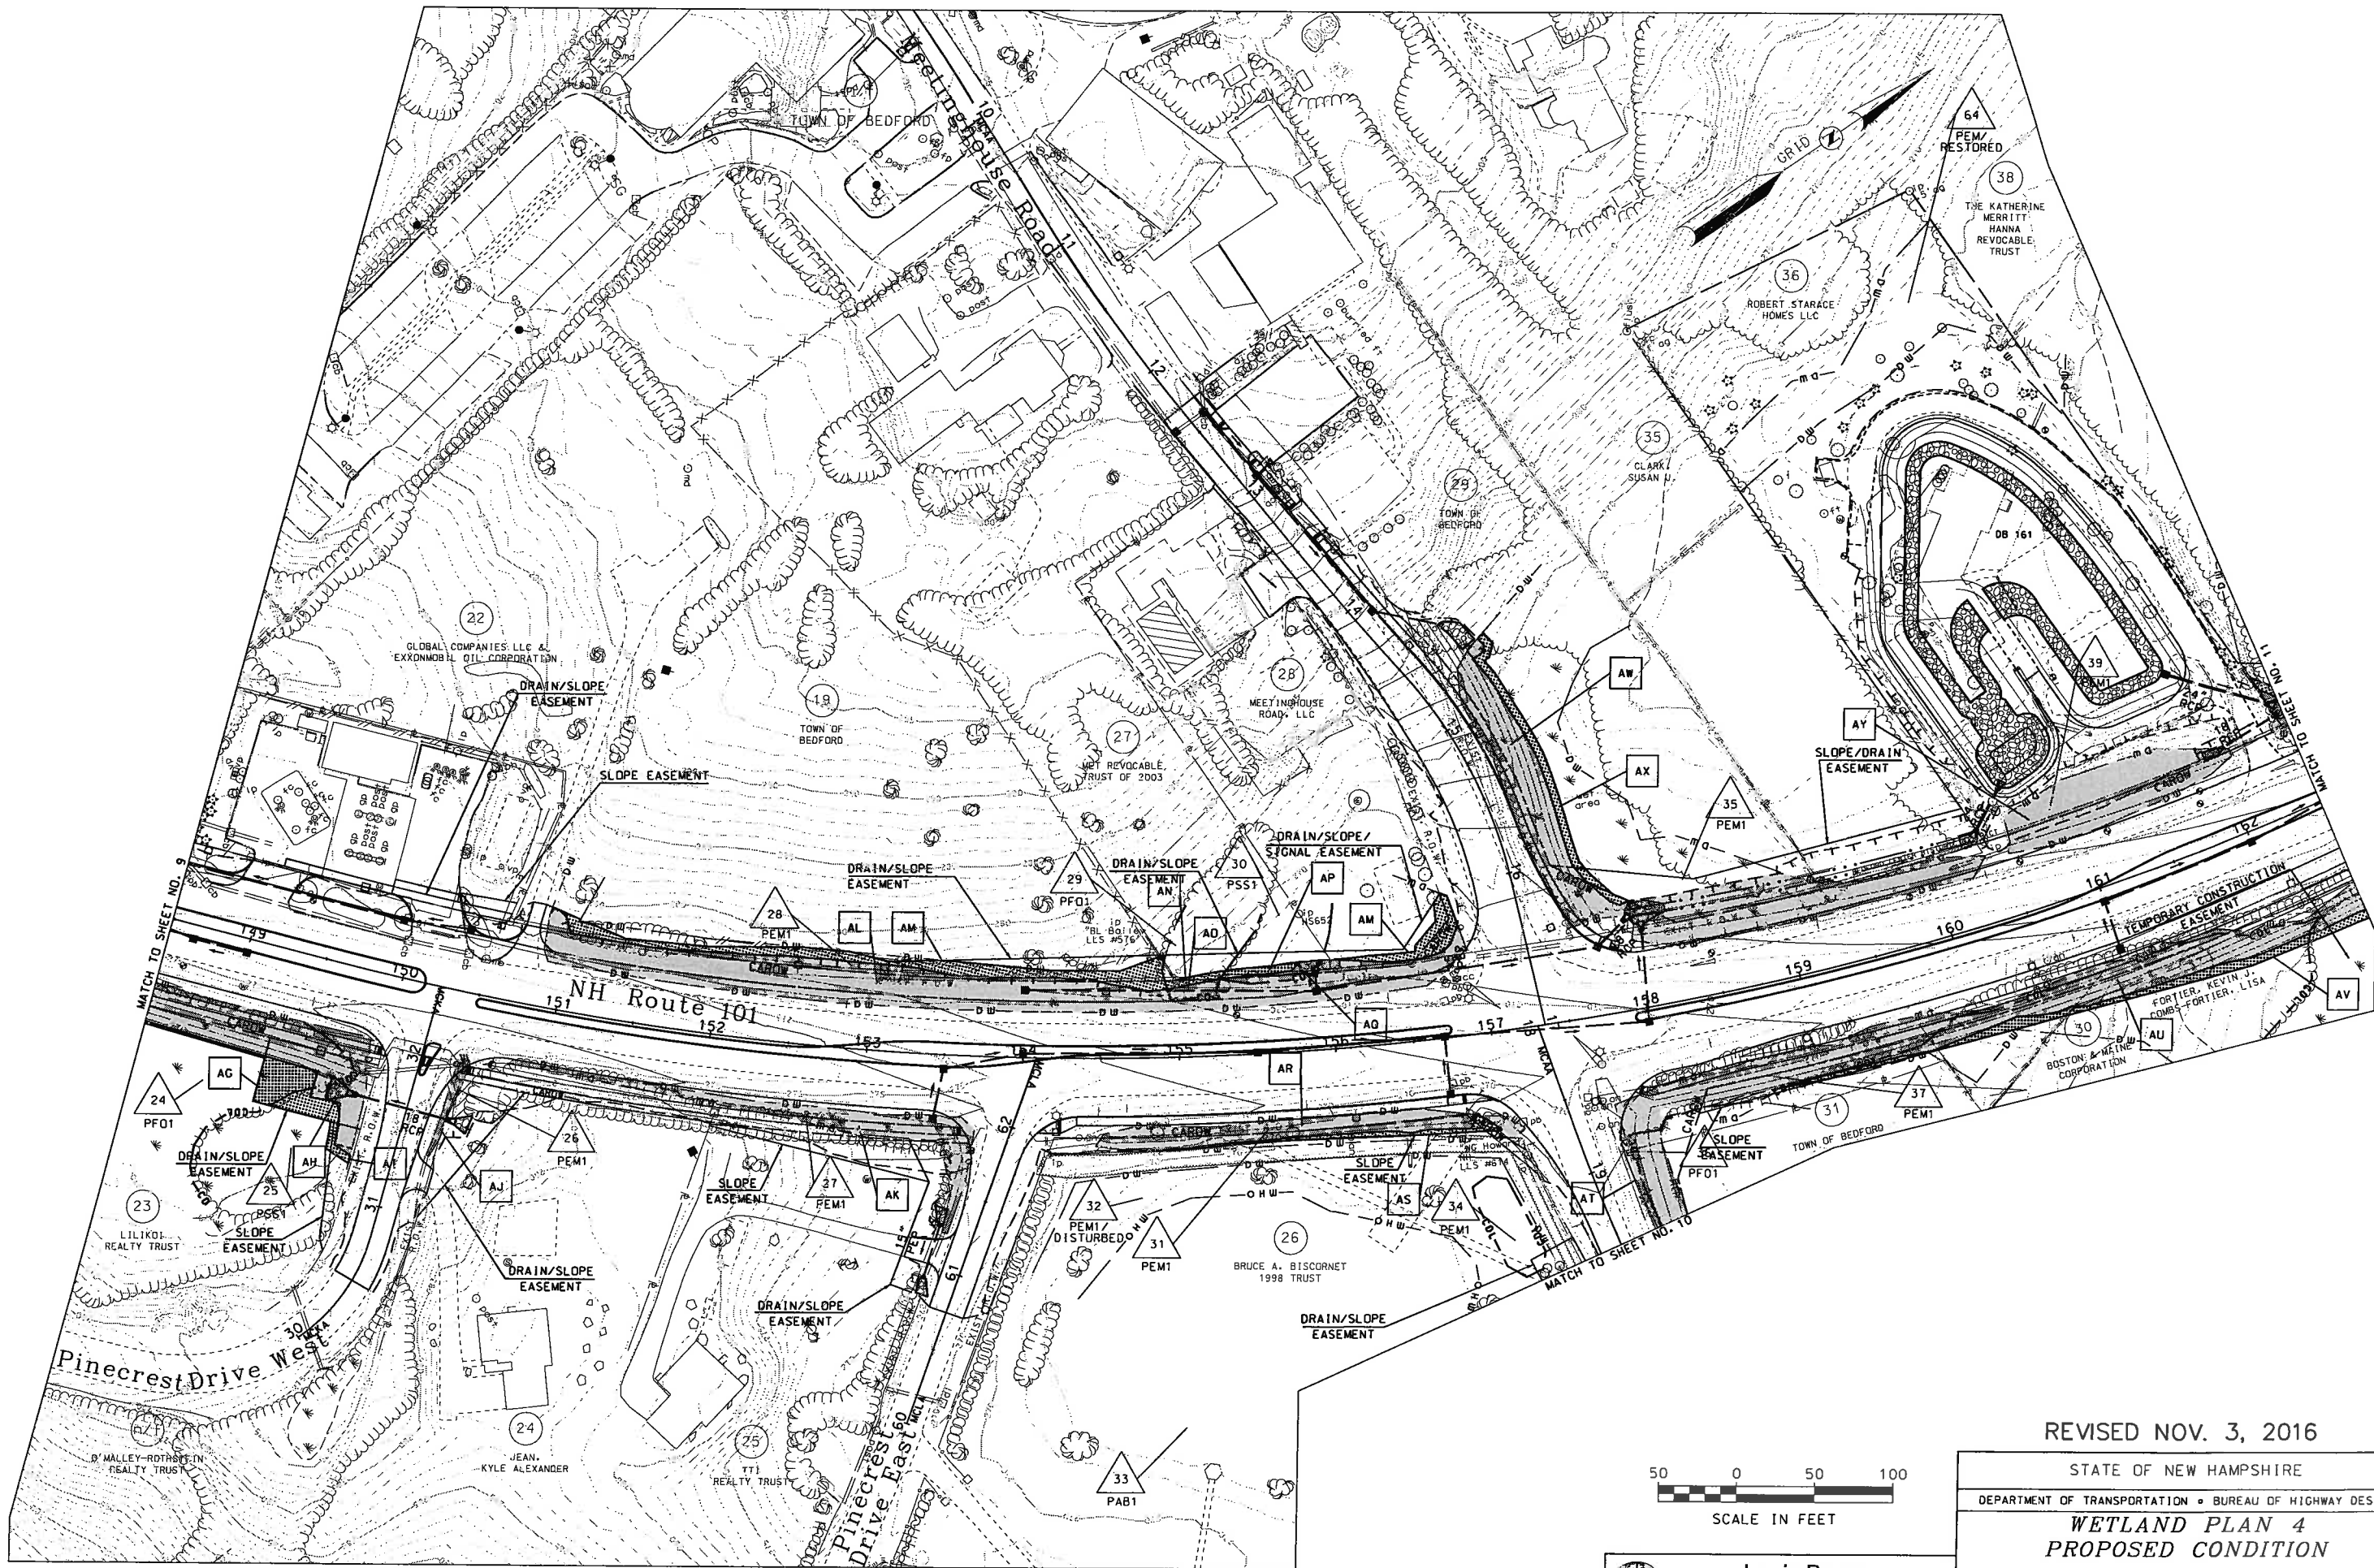

Louis Berger
Manchester, New Hampshire
(603) 644 5200

| | | | |
|---------------------------------------------------------|-------------------|-----------|--------------|
| REVISED NOV. 3, 2016 | | | |
| STATE OF NEW HAMPSHIRE | | | |
| DEPARTMENT OF TRANSPORTATION • BUREAU OF HIGHWAY DESIGN | | | |
| WETLAND PLAN 4 | | | |
| PROPOSED CONDITION | | | |
| DGN | STATE PROJECT NO. | SHEET NO. | TOTAL SHEETS |
| WETPLANS 04 | 13953 | 9 | 25 |

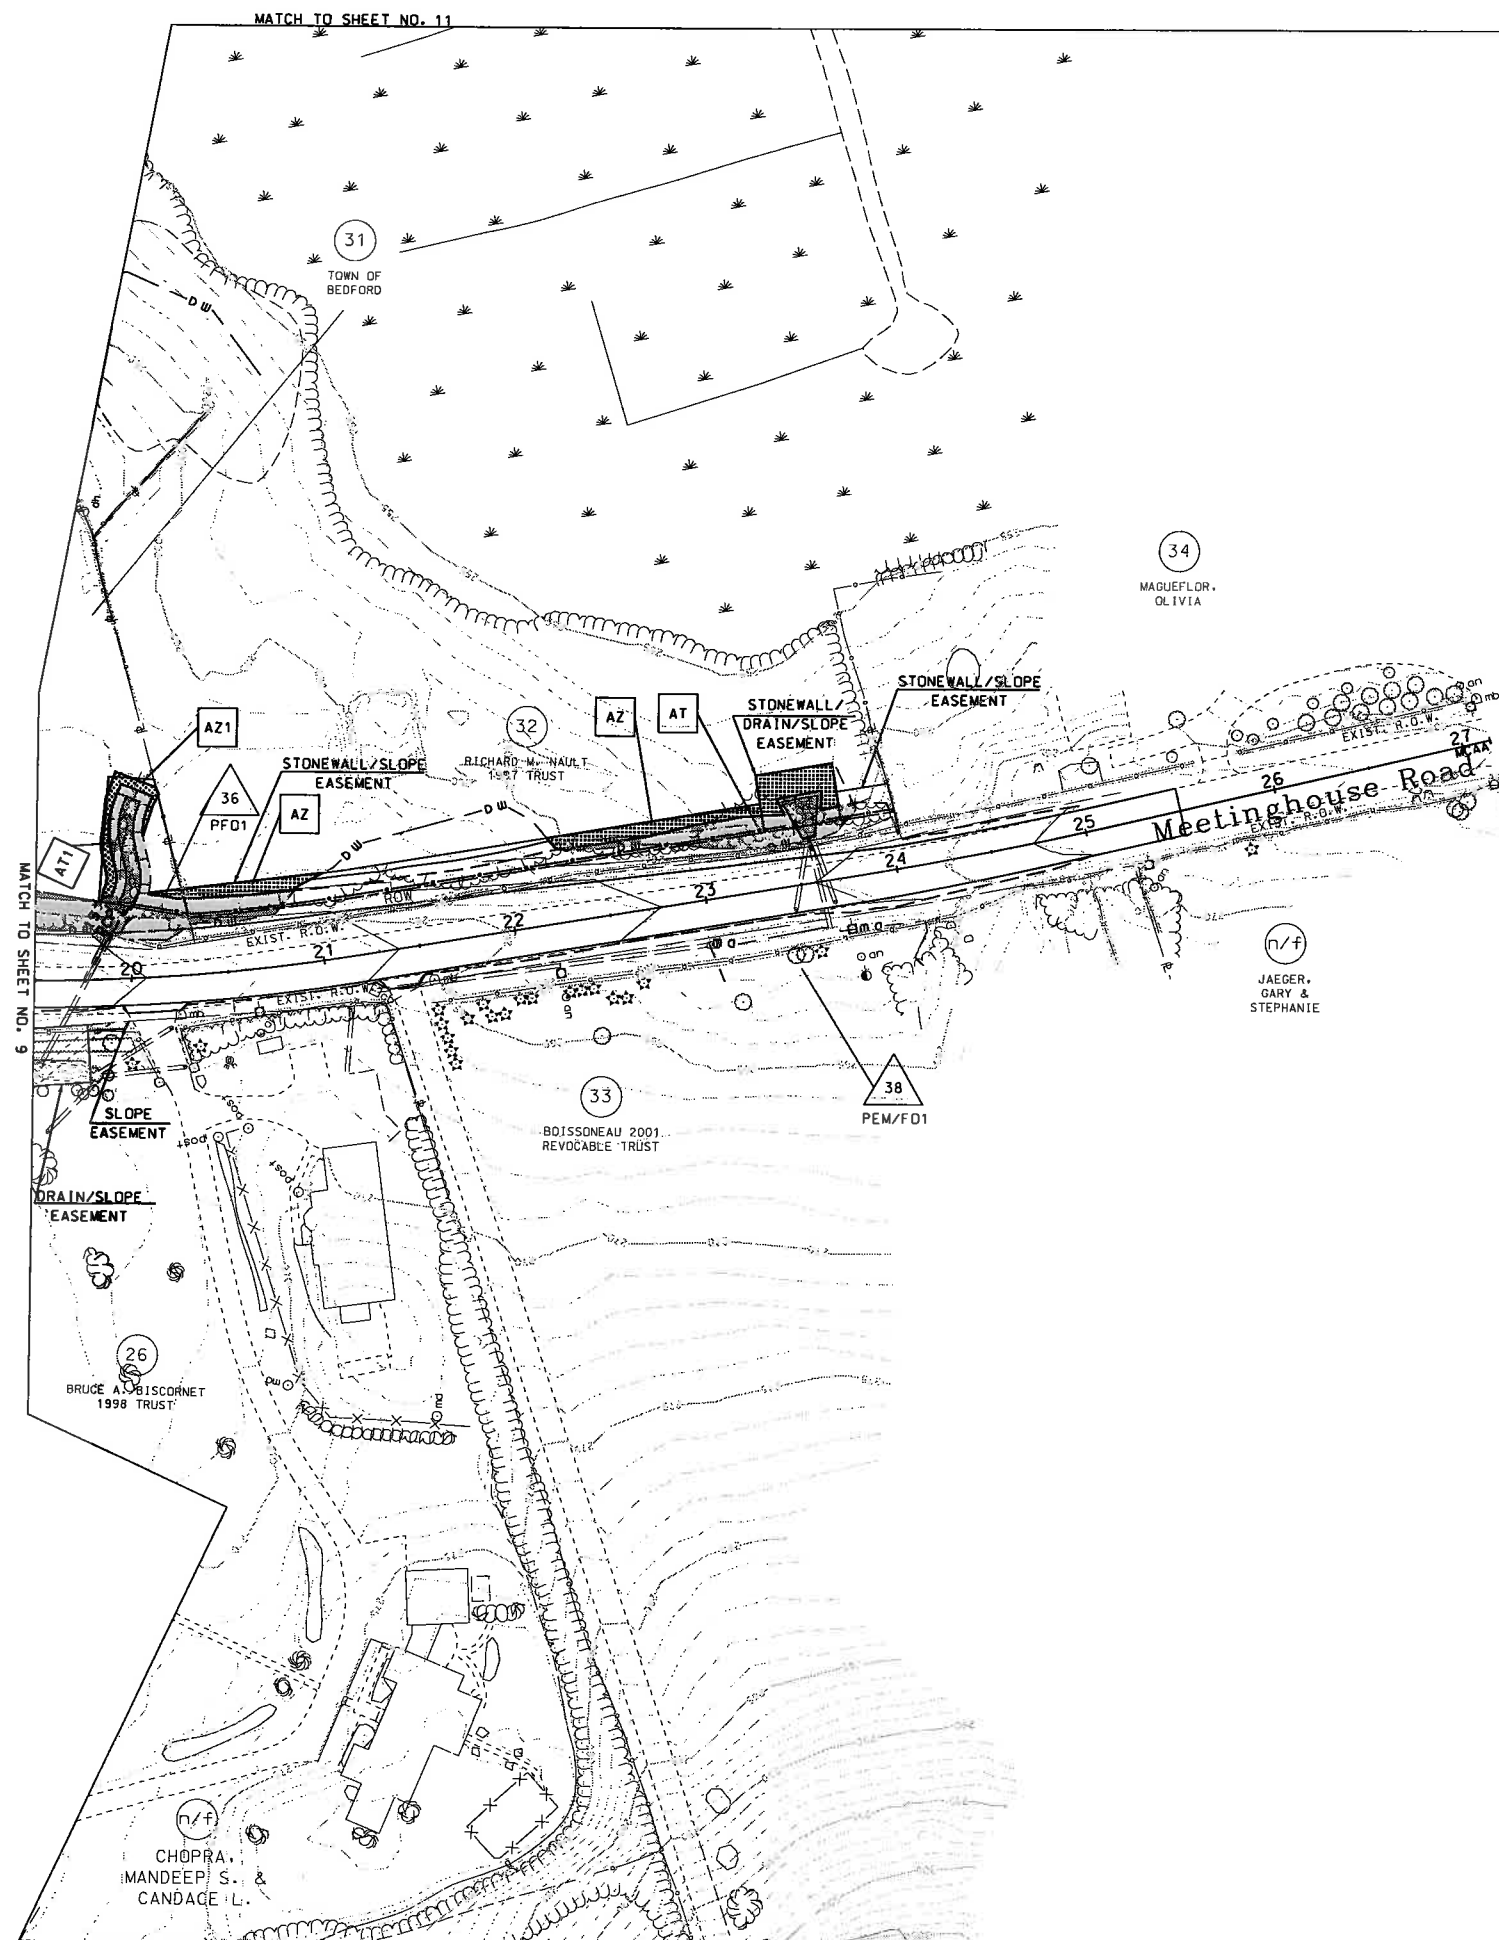[illegible]


Louis Berger
Manchester, New Hampshire
(603) 644 5200

REVISÉ NOV. 3, 2016

STATE OF NEW HAMPSHIRE
DEPARTMENT OF TRANSPORTATION • BUREAU OF HIGHWAY DESIGN

WETLAND PLAN 5
PROPOSED CONDITION

| | | | |
|-------------|-------------------|-----------|--------------|
| DGN | STATE PROJECT NO. | SHEET NO. | TOTAL SHEETS |
| WETPLANS 05 | 13953 | 10 | 25 |

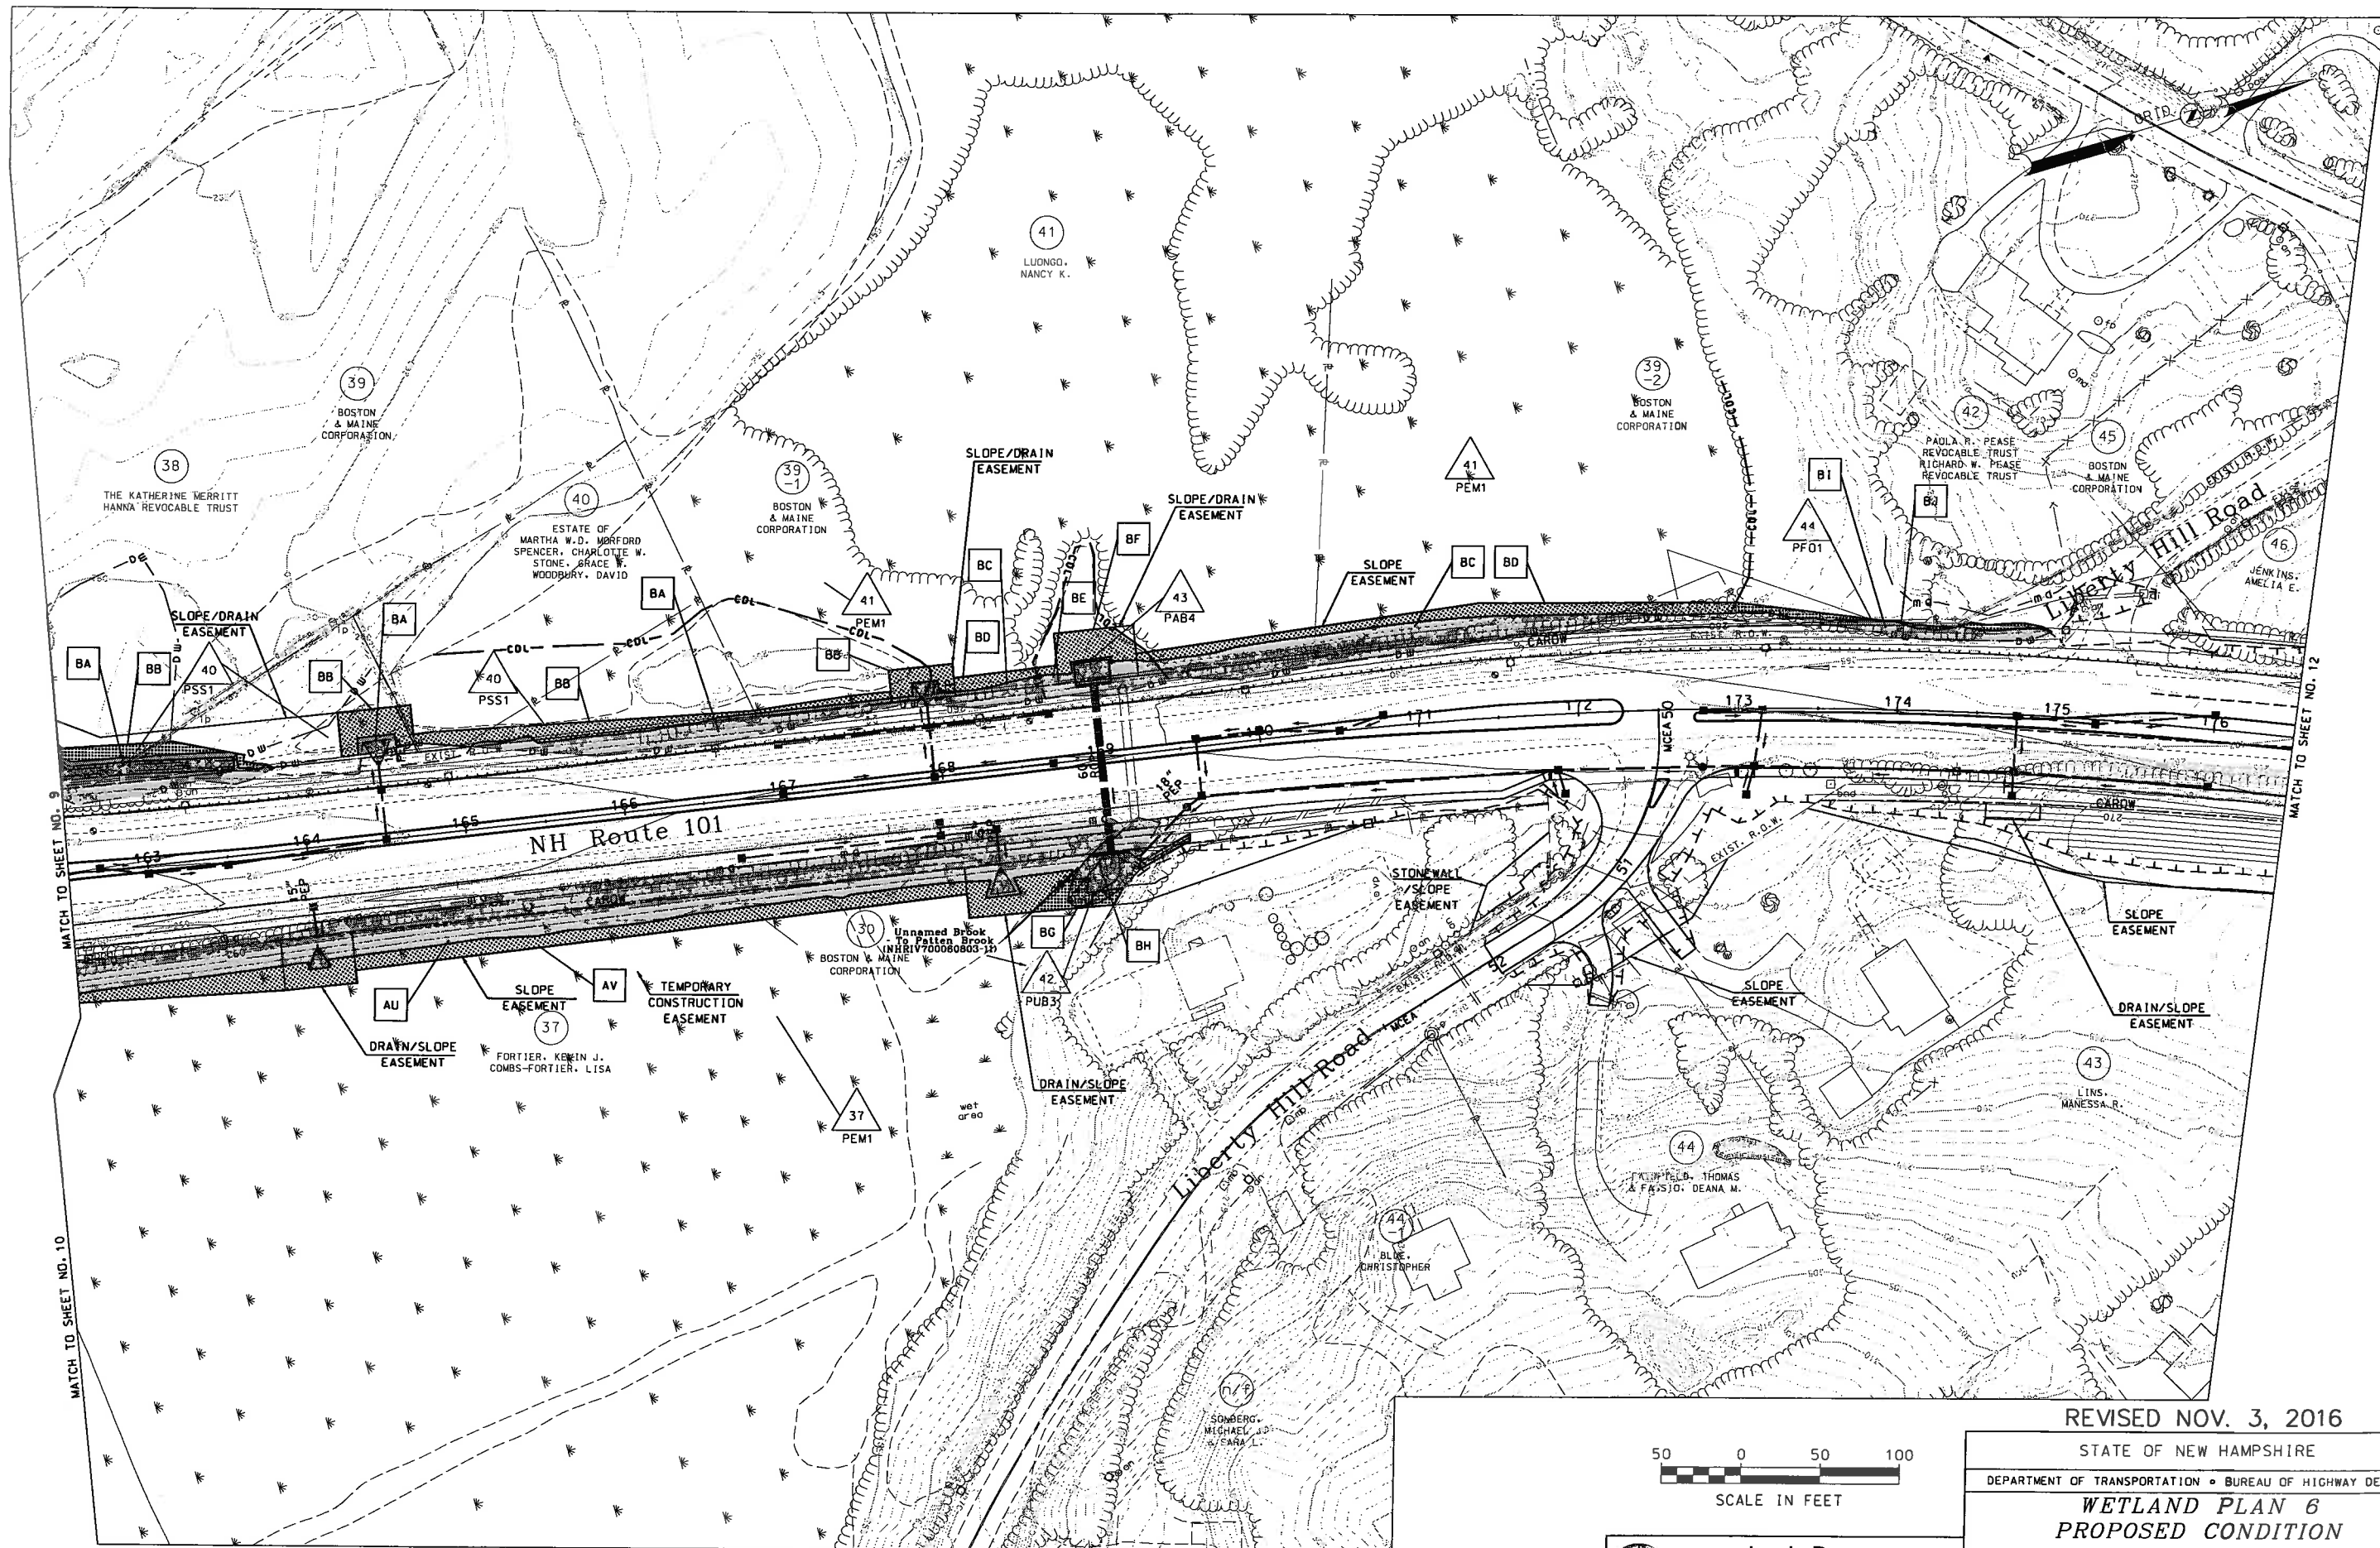[illegible]

REVISÉ NOV. 3, 2016

STATE OF NEW HAMPSHIRE

DEPARTMENT OF TRANSPORTATION • BUREAU OF HIGHWAY DESIGN


WETLAND PLAN 6
PROPOSED CONDITION

| DGN | STATE PROJECT NO. | SHEET NO. | TOTAL SHEETS |
|-------------|-------------------|-----------|--------------|
| WETPLANS 06 | 13953 | 11 | 25 |




Louis Berger
Manchester, New Hampshire
(603) 644 5200

| REVISIONS AFTER PROPOSAL | | STATION | | DESCRIPTION | |
|--------------------------|----------|---------------|----------|-------------|----------|
| NUMBER | DATE | NUMBER | DATE | NUMBER | DATE |
| SDR PROCESSED | DATE | NEW DESIGN | DATE | ERW | DATE |
| NEW DESIGN | 08/23/16 | SHEET CHECKED | 08/23/16 | LSF | 08/23/16 |
| AS BUILT DETAILS | DATE | | | | |

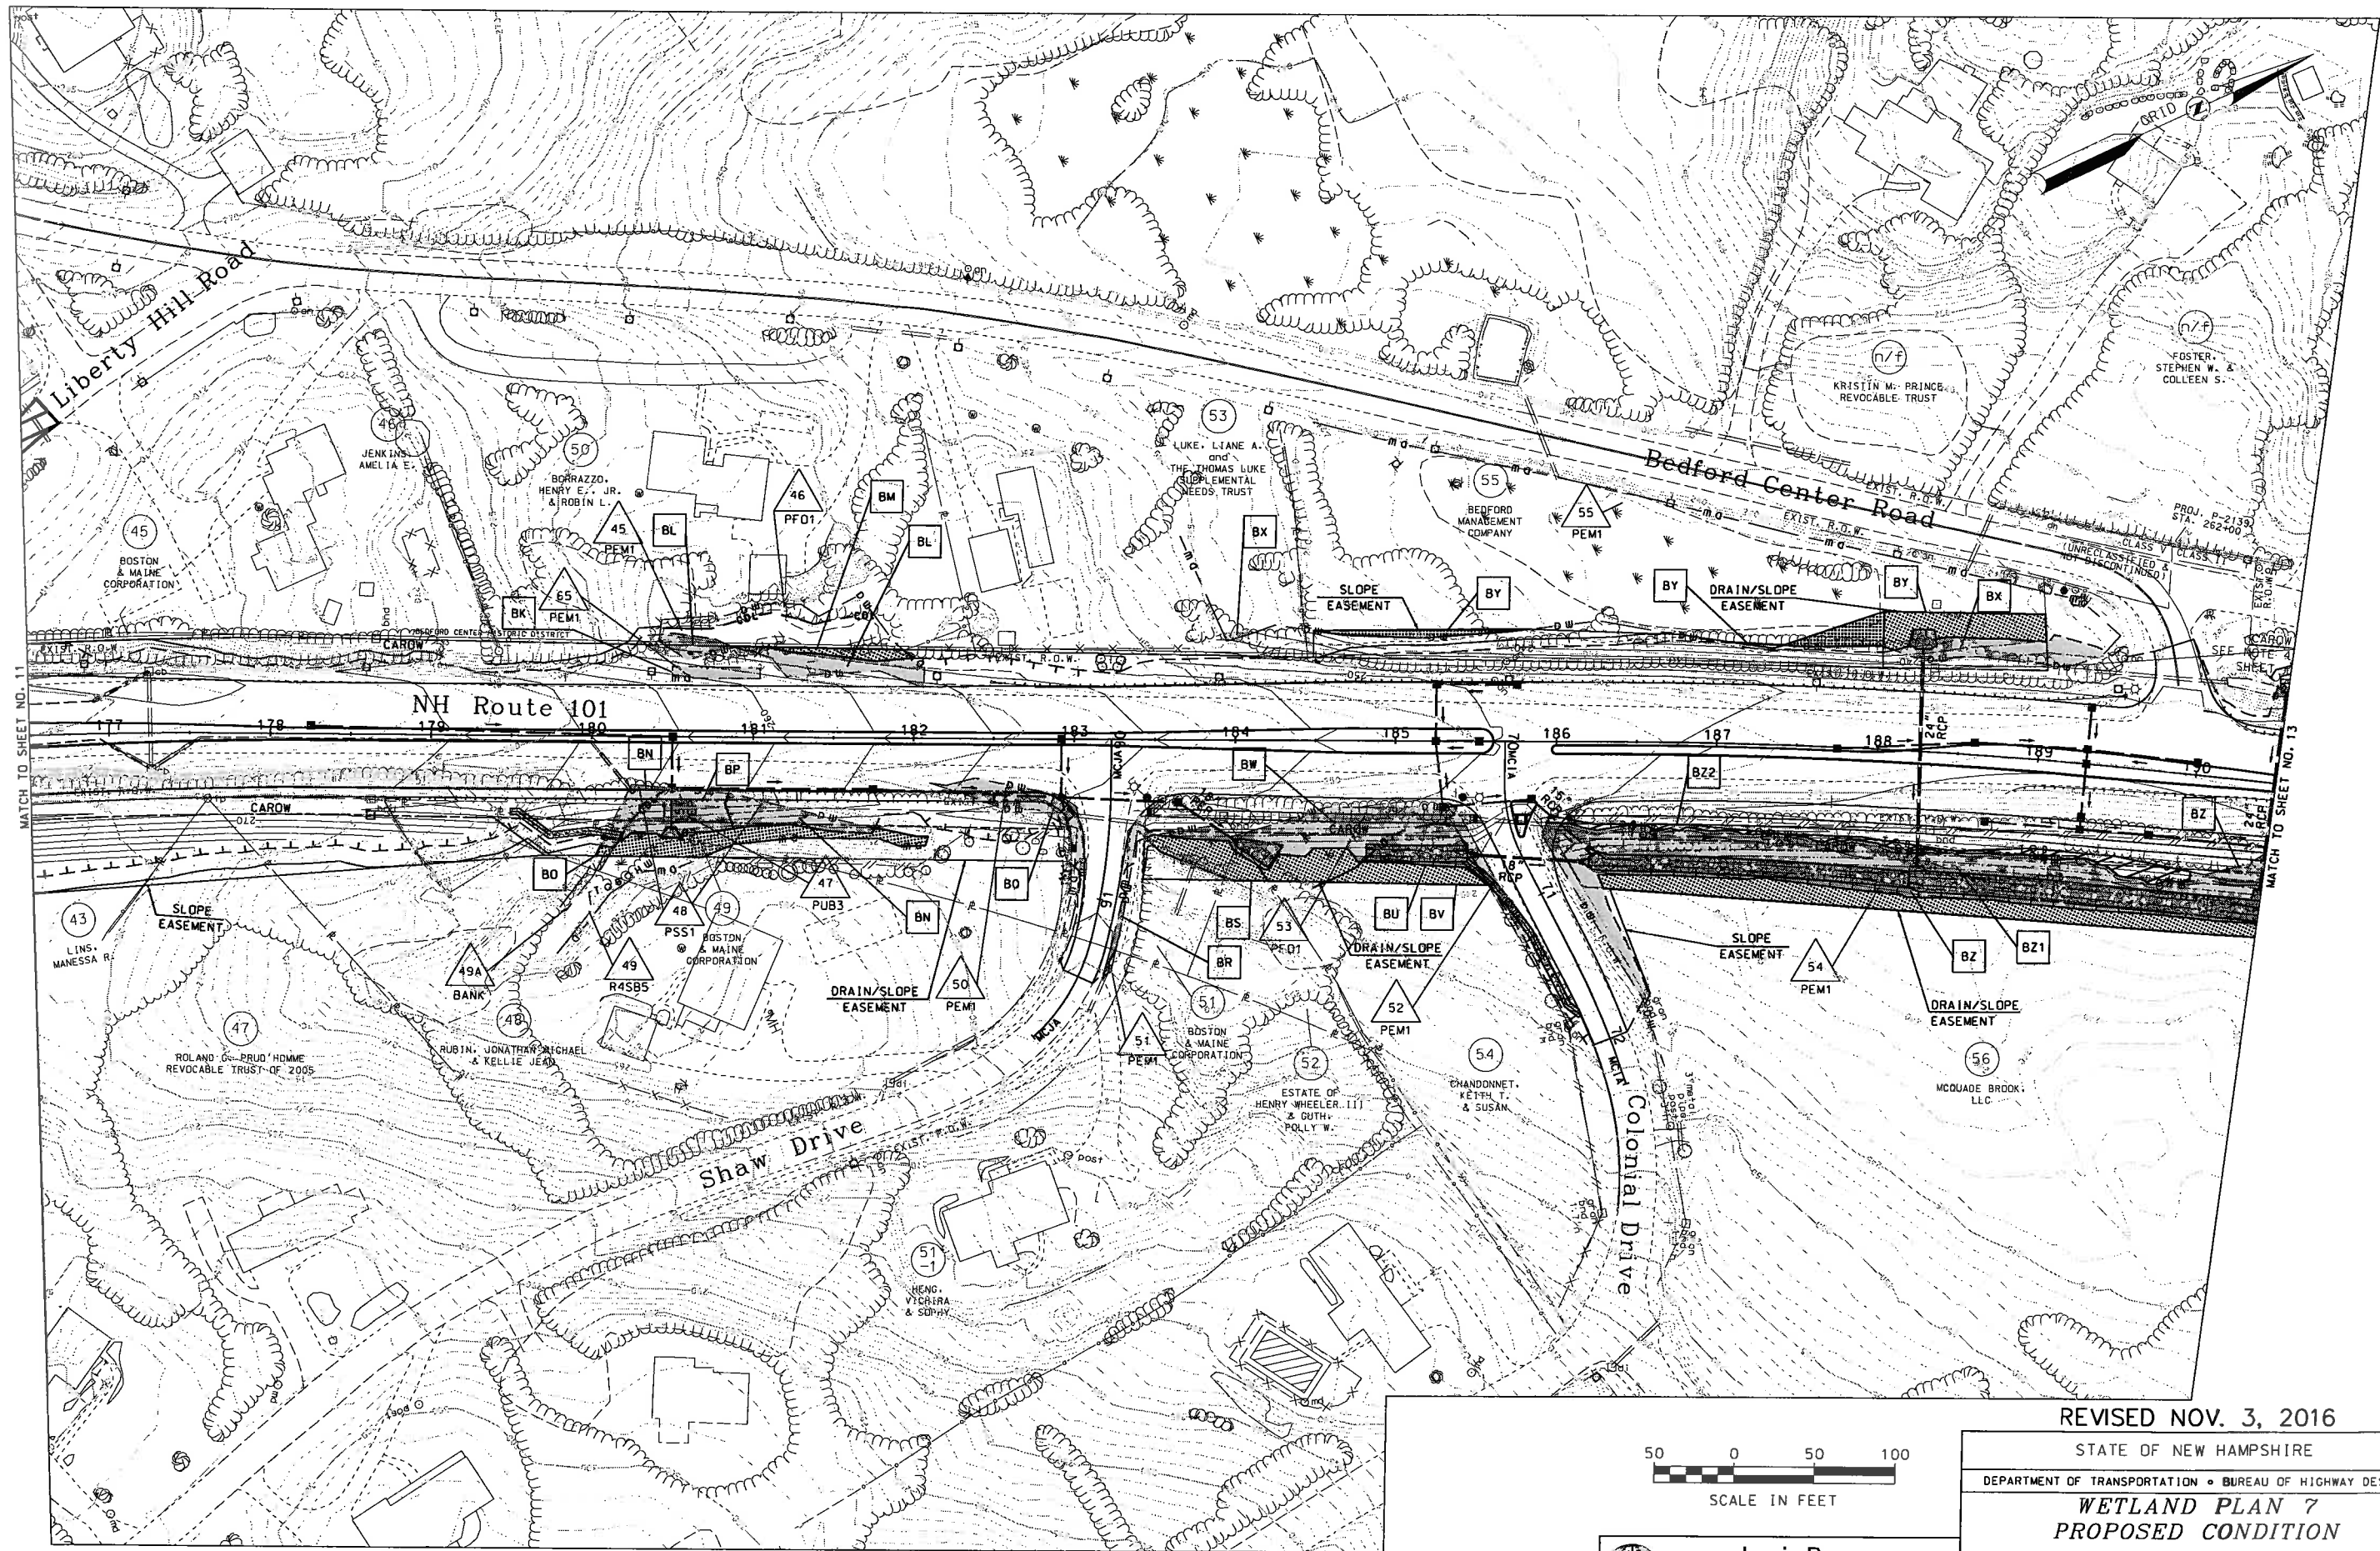

50 0 50 100

SCALE IN FEET

 Louis Berger
Manchester, New Hampshire
(603) 644 5200

REVISED NOV. 3, 2016


STATE OF NEW HAMPSHIRE

DEPARTMENT OF TRANSPORTATION • BUREAU OF HIGHWAY DESIGN

WETLAND PLAN 7

PROPOSED CONDITION

| | | | |
|-------------|-------------------|-----------|--------------|
| DGN | STATE PROJECT NO. | SHEET NO. | TOTAL SHEETS |
| WETPLANS 07 | 13953 | 12 | 25 |

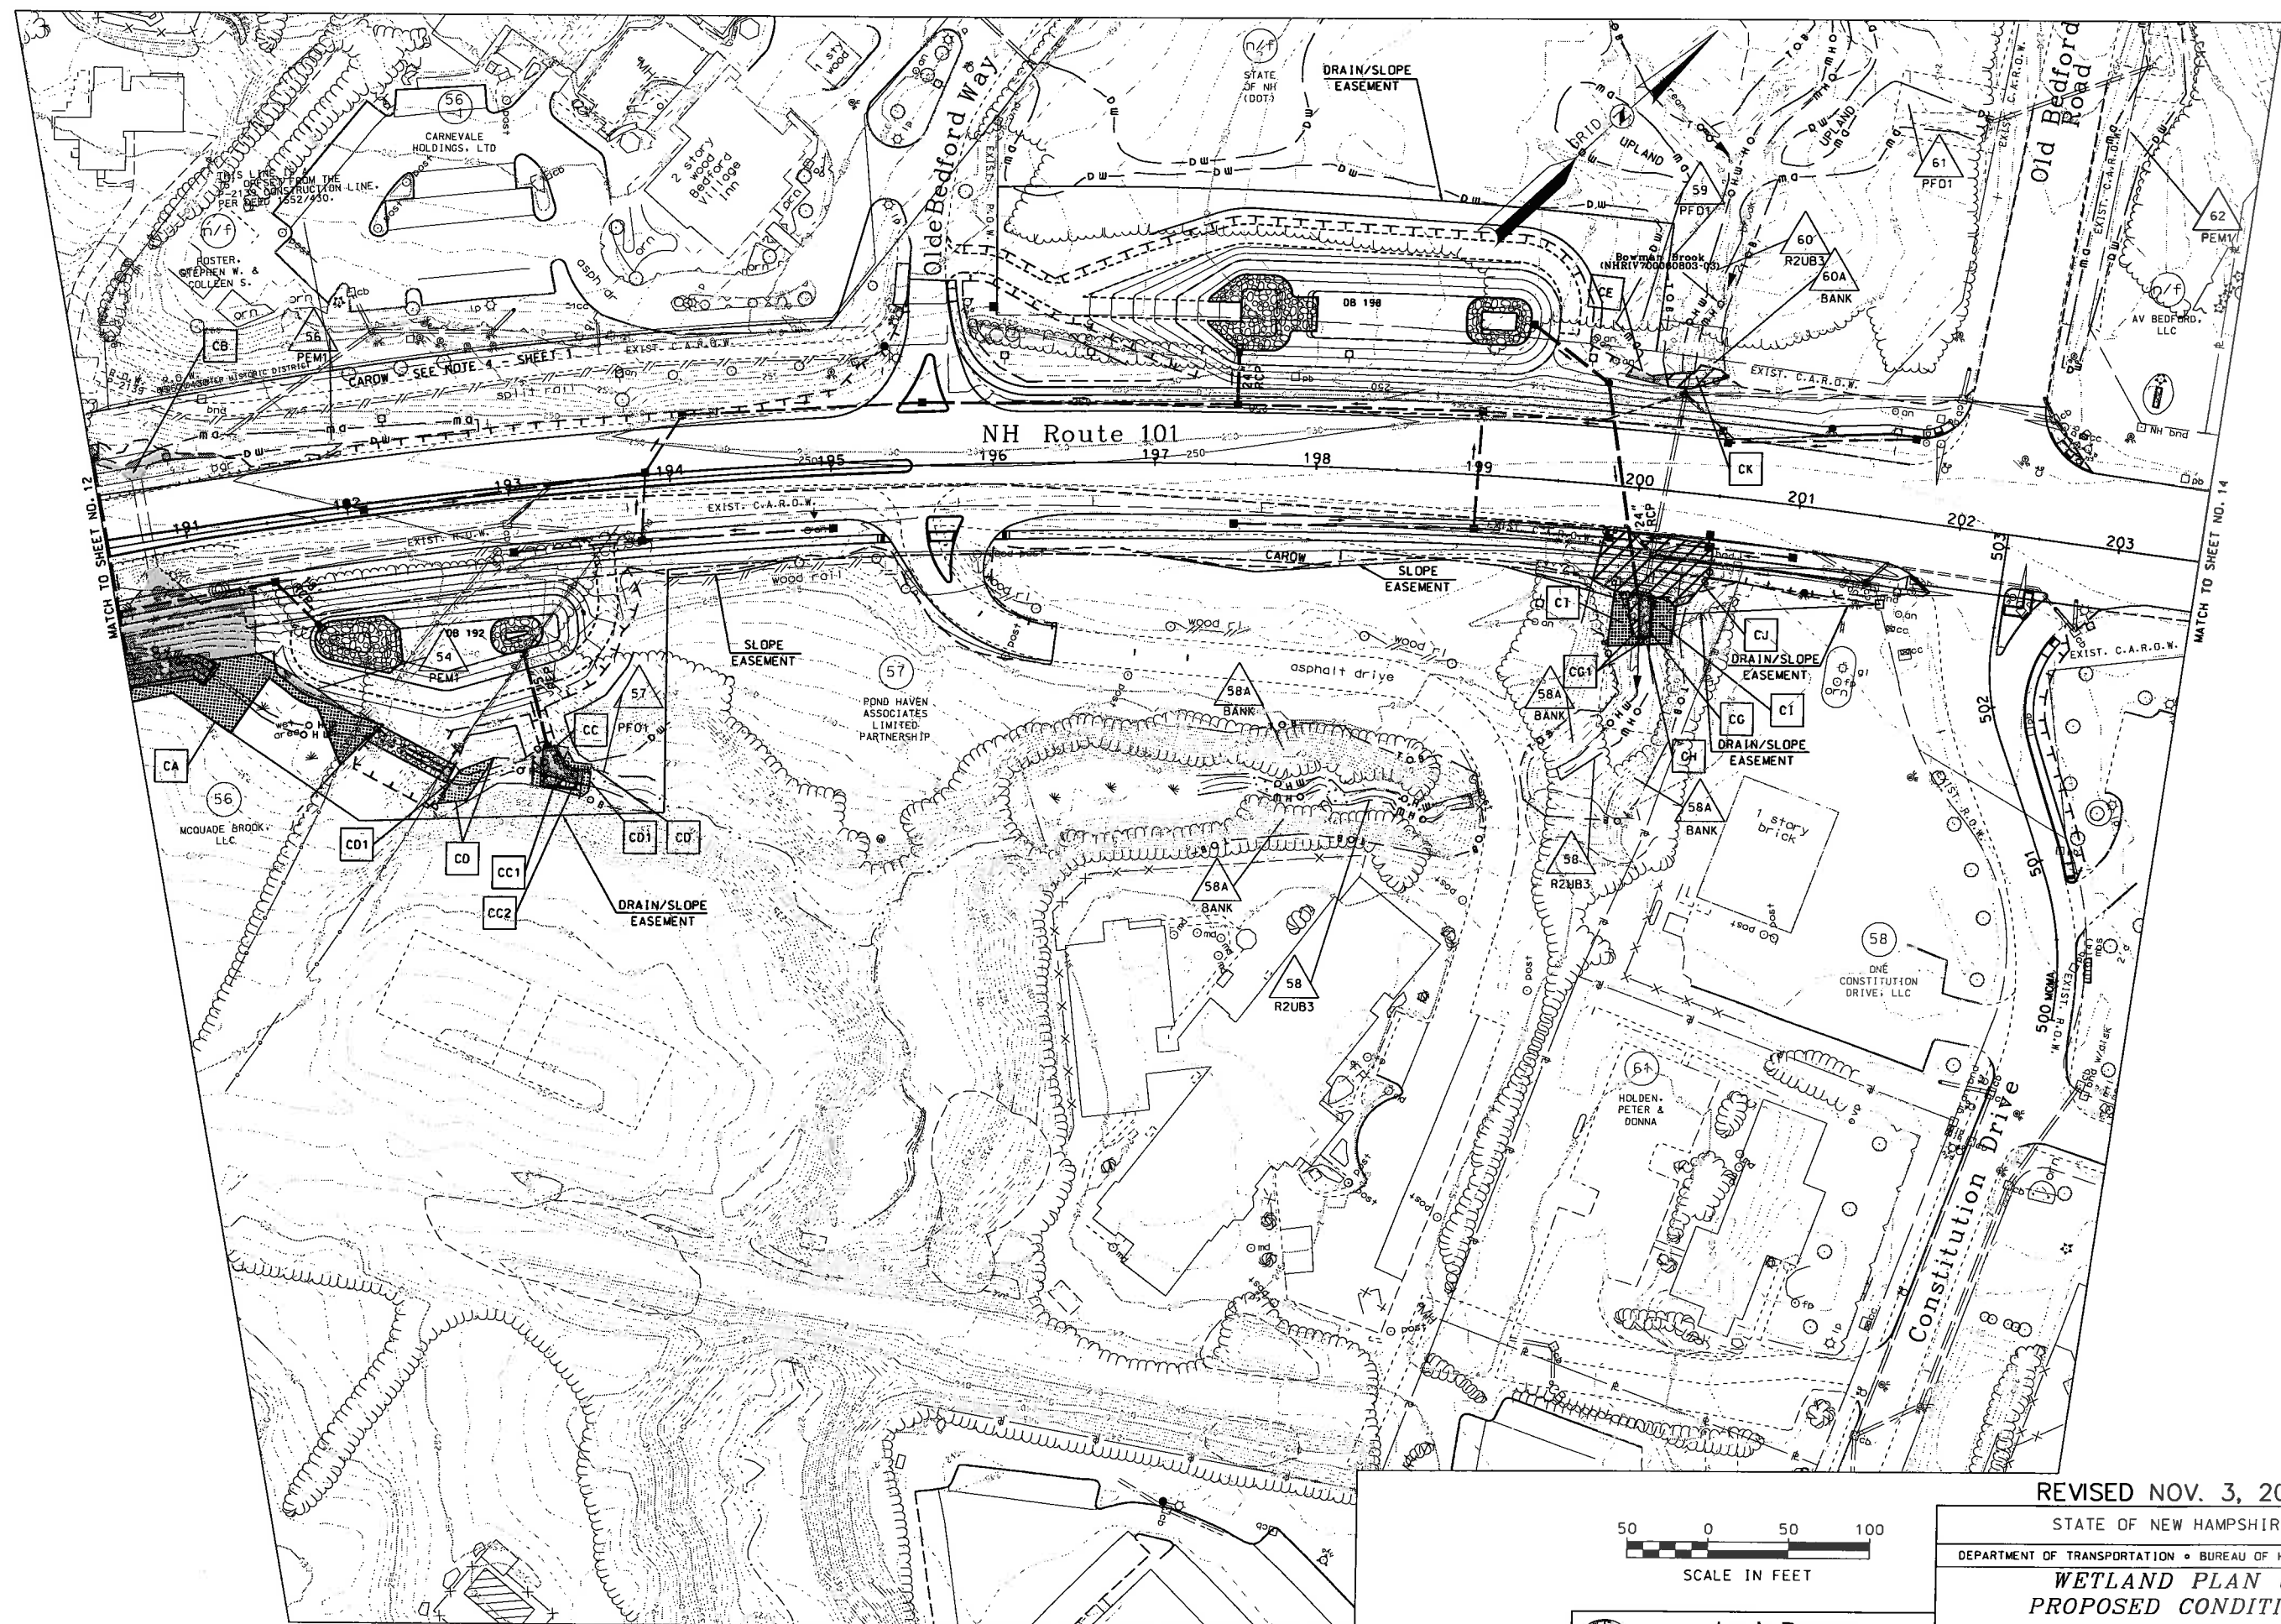[illegible]

REVISÉ NOV. 3, 2016

STATE OF NEW HAMPSHIRE
DEPARTMENT OF TRANSPORTATION • BUREAU OF HIGHWAY DESIGN


WETLAND PLAN 8
PROPOSED CONDITION

| DGN | STATE PROJECT NO. | SHEET NO. | TOTAL SHEETS |
|-------------|-------------------|-----------|--------------|
| WETPLANS 08 | 13953 | 13 | 25 |

A horizontal scale bar with markings at 50, 0, 50, and 100. The bar is divided into alternating black and white segments. Below the bar, the text "SCALE IN FEET" is written.



Louis Berger
Manchester, New Hampshire
(603) 644 5200

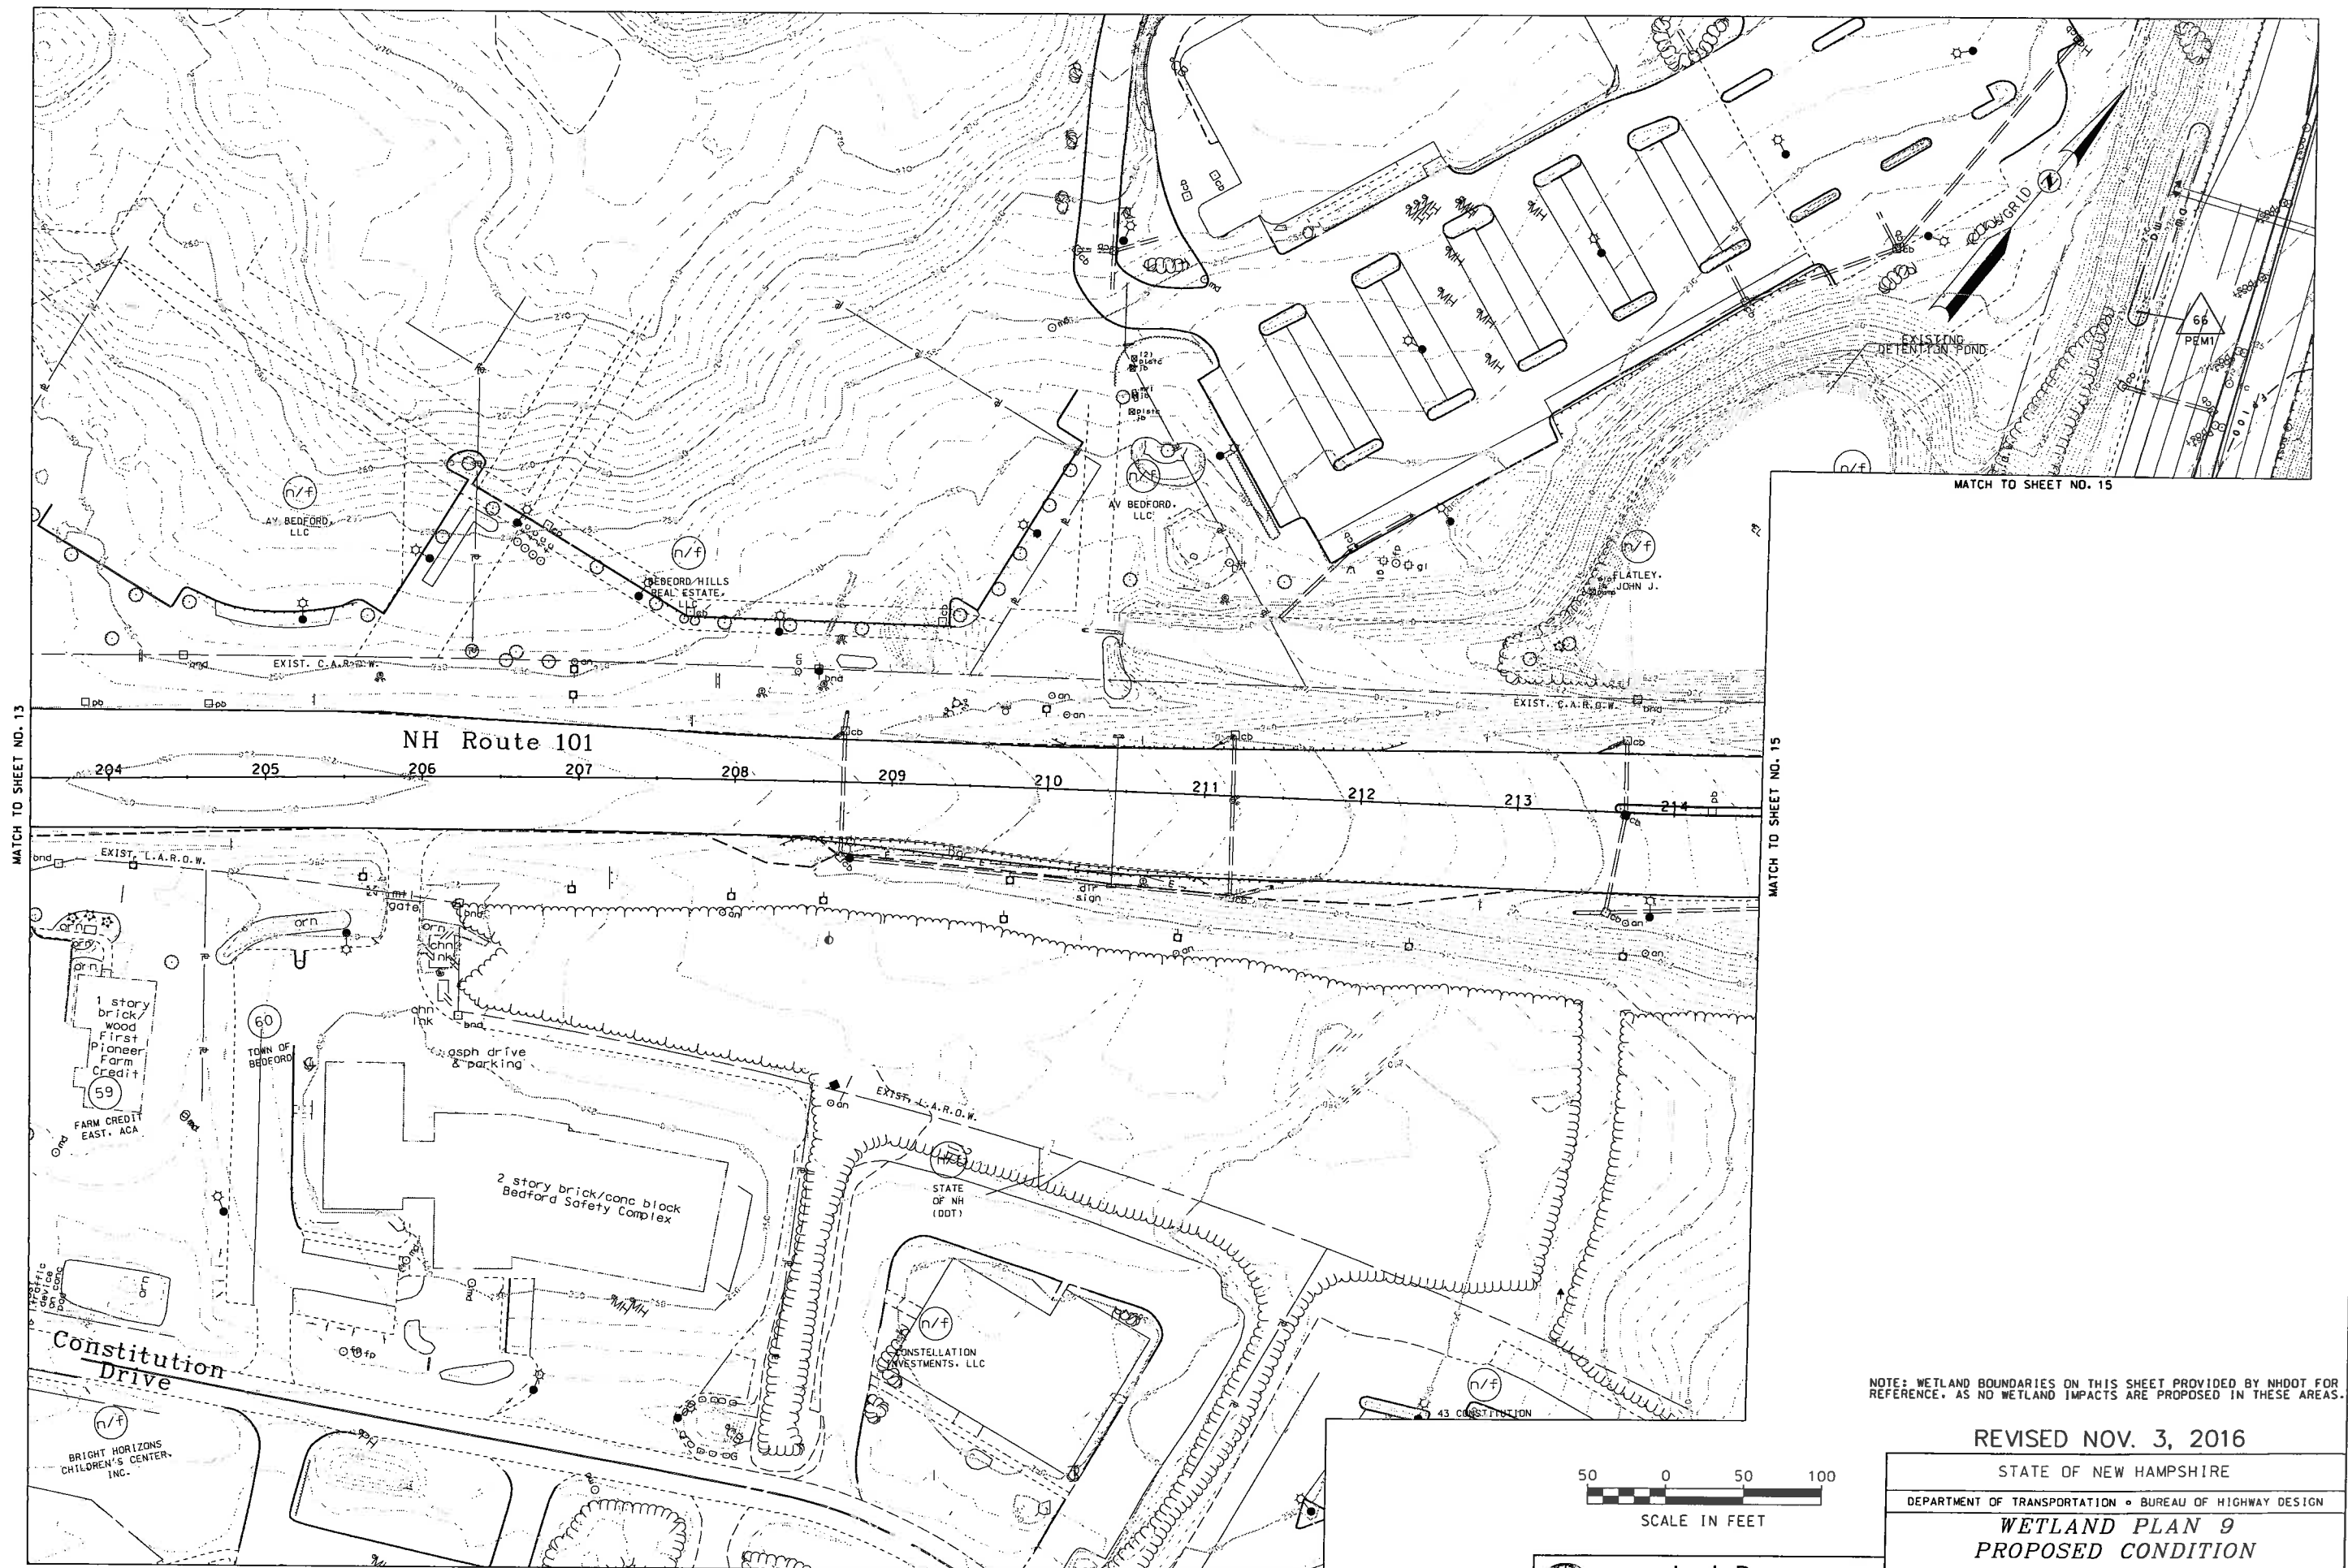[illegible]

NOTE: WETLAND BOUNDARIES ON THIS SHEET PROVIDED BY NHDOT FOR REFERENCE. AS NO WETLAND IMPACTS ARE PROPOSED IN THESE AREAS.

REVISÉ NOV. 3, 2016

STATE OF NEW HAMPSHIRE

DEPARTMENT OF TRANSPORTATION • BUREAU OF HIGHWAY DESIGN


WETLAND PLAN 9
PROPOSED CONDITION

| OGN | STATE PROJECT NO. | SHEET NO. | TOTAL SHEETS |
|-------------|-------------------|-----------|--------------|
| WETPLANS 09 | 13953 | 14 | 25 |





Louis Berger
Manchester, New Hampshire
(603) 644 5200

| SDR PROCESSED | | REVISIONS AFTER PROPOSAL | |
|------------------|----------|--------------------------|-------------|
| NEW DESIGN | ERW | STATION | DESCRIPTION |
| SHEET CHECKED | LSF | | |
| AS BUILT DETAILS | | | |
| DATE | DATE | DATE | DATE |
| 08/23/16 | 08/23/16 | | |
| 08/23/16 | 08/23/16 | | |
| | | | |

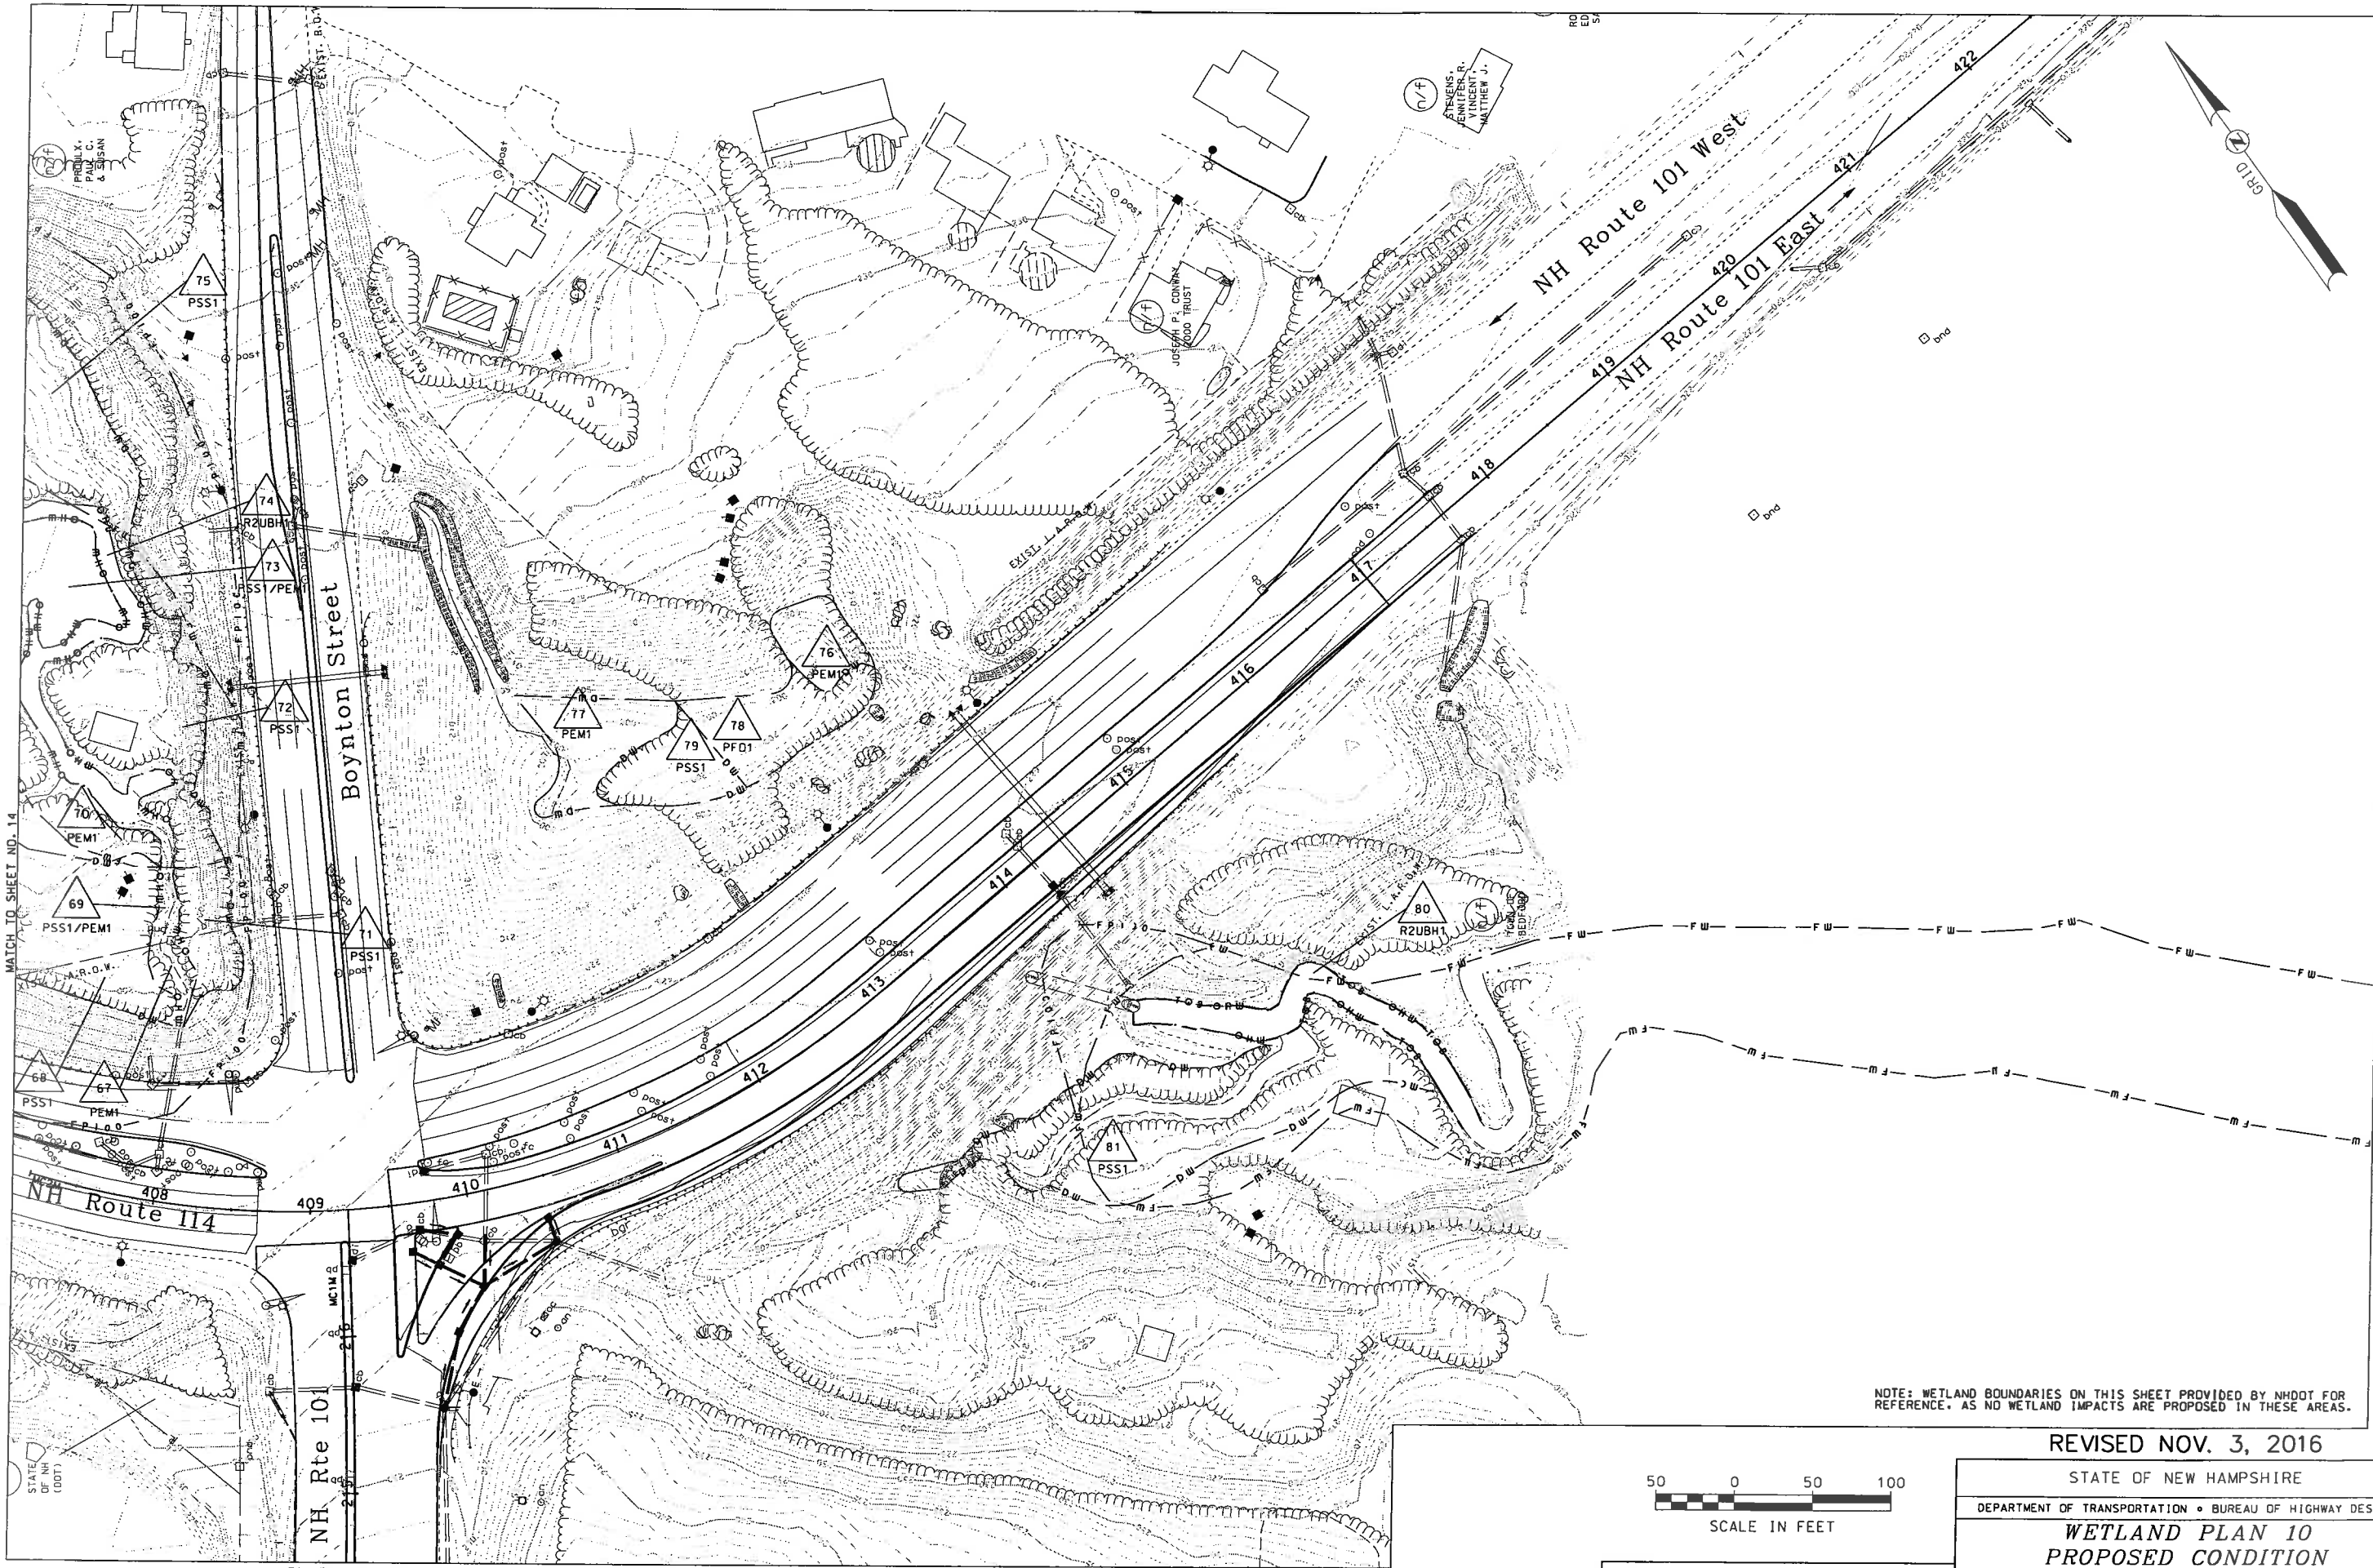


NOTE: WETLAND BOUNDARIES ON THIS SHEET PROVIDED BY NHDOT FOR REFERENCE. AS NO WETLAND IMPACTS ARE PROPOSED IN THESE AREAS.

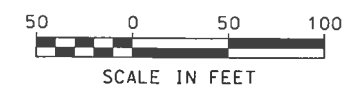


 **Louis Berger**
Manchester, New Hampshire
(603) 644 5200

| REVISED NOV. 3, 2016 | | | |
|---------------------------------------------------------|-------------------|-----------|--------------|
| STATE OF NEW HAMPSHIRE | | | |
| DEPARTMENT OF TRANSPORTATION • BUREAU OF HIGHWAY DESIGN | | | |
| WETLAND PLAN 10 | | | |
| PROPOSED CONDITION | | | |
| DGN | STATE PROJECT NO. | SHEET NO. | TOTAL SHEETS |
| WETPLANS 10 | 13953 | 15 | 25 |

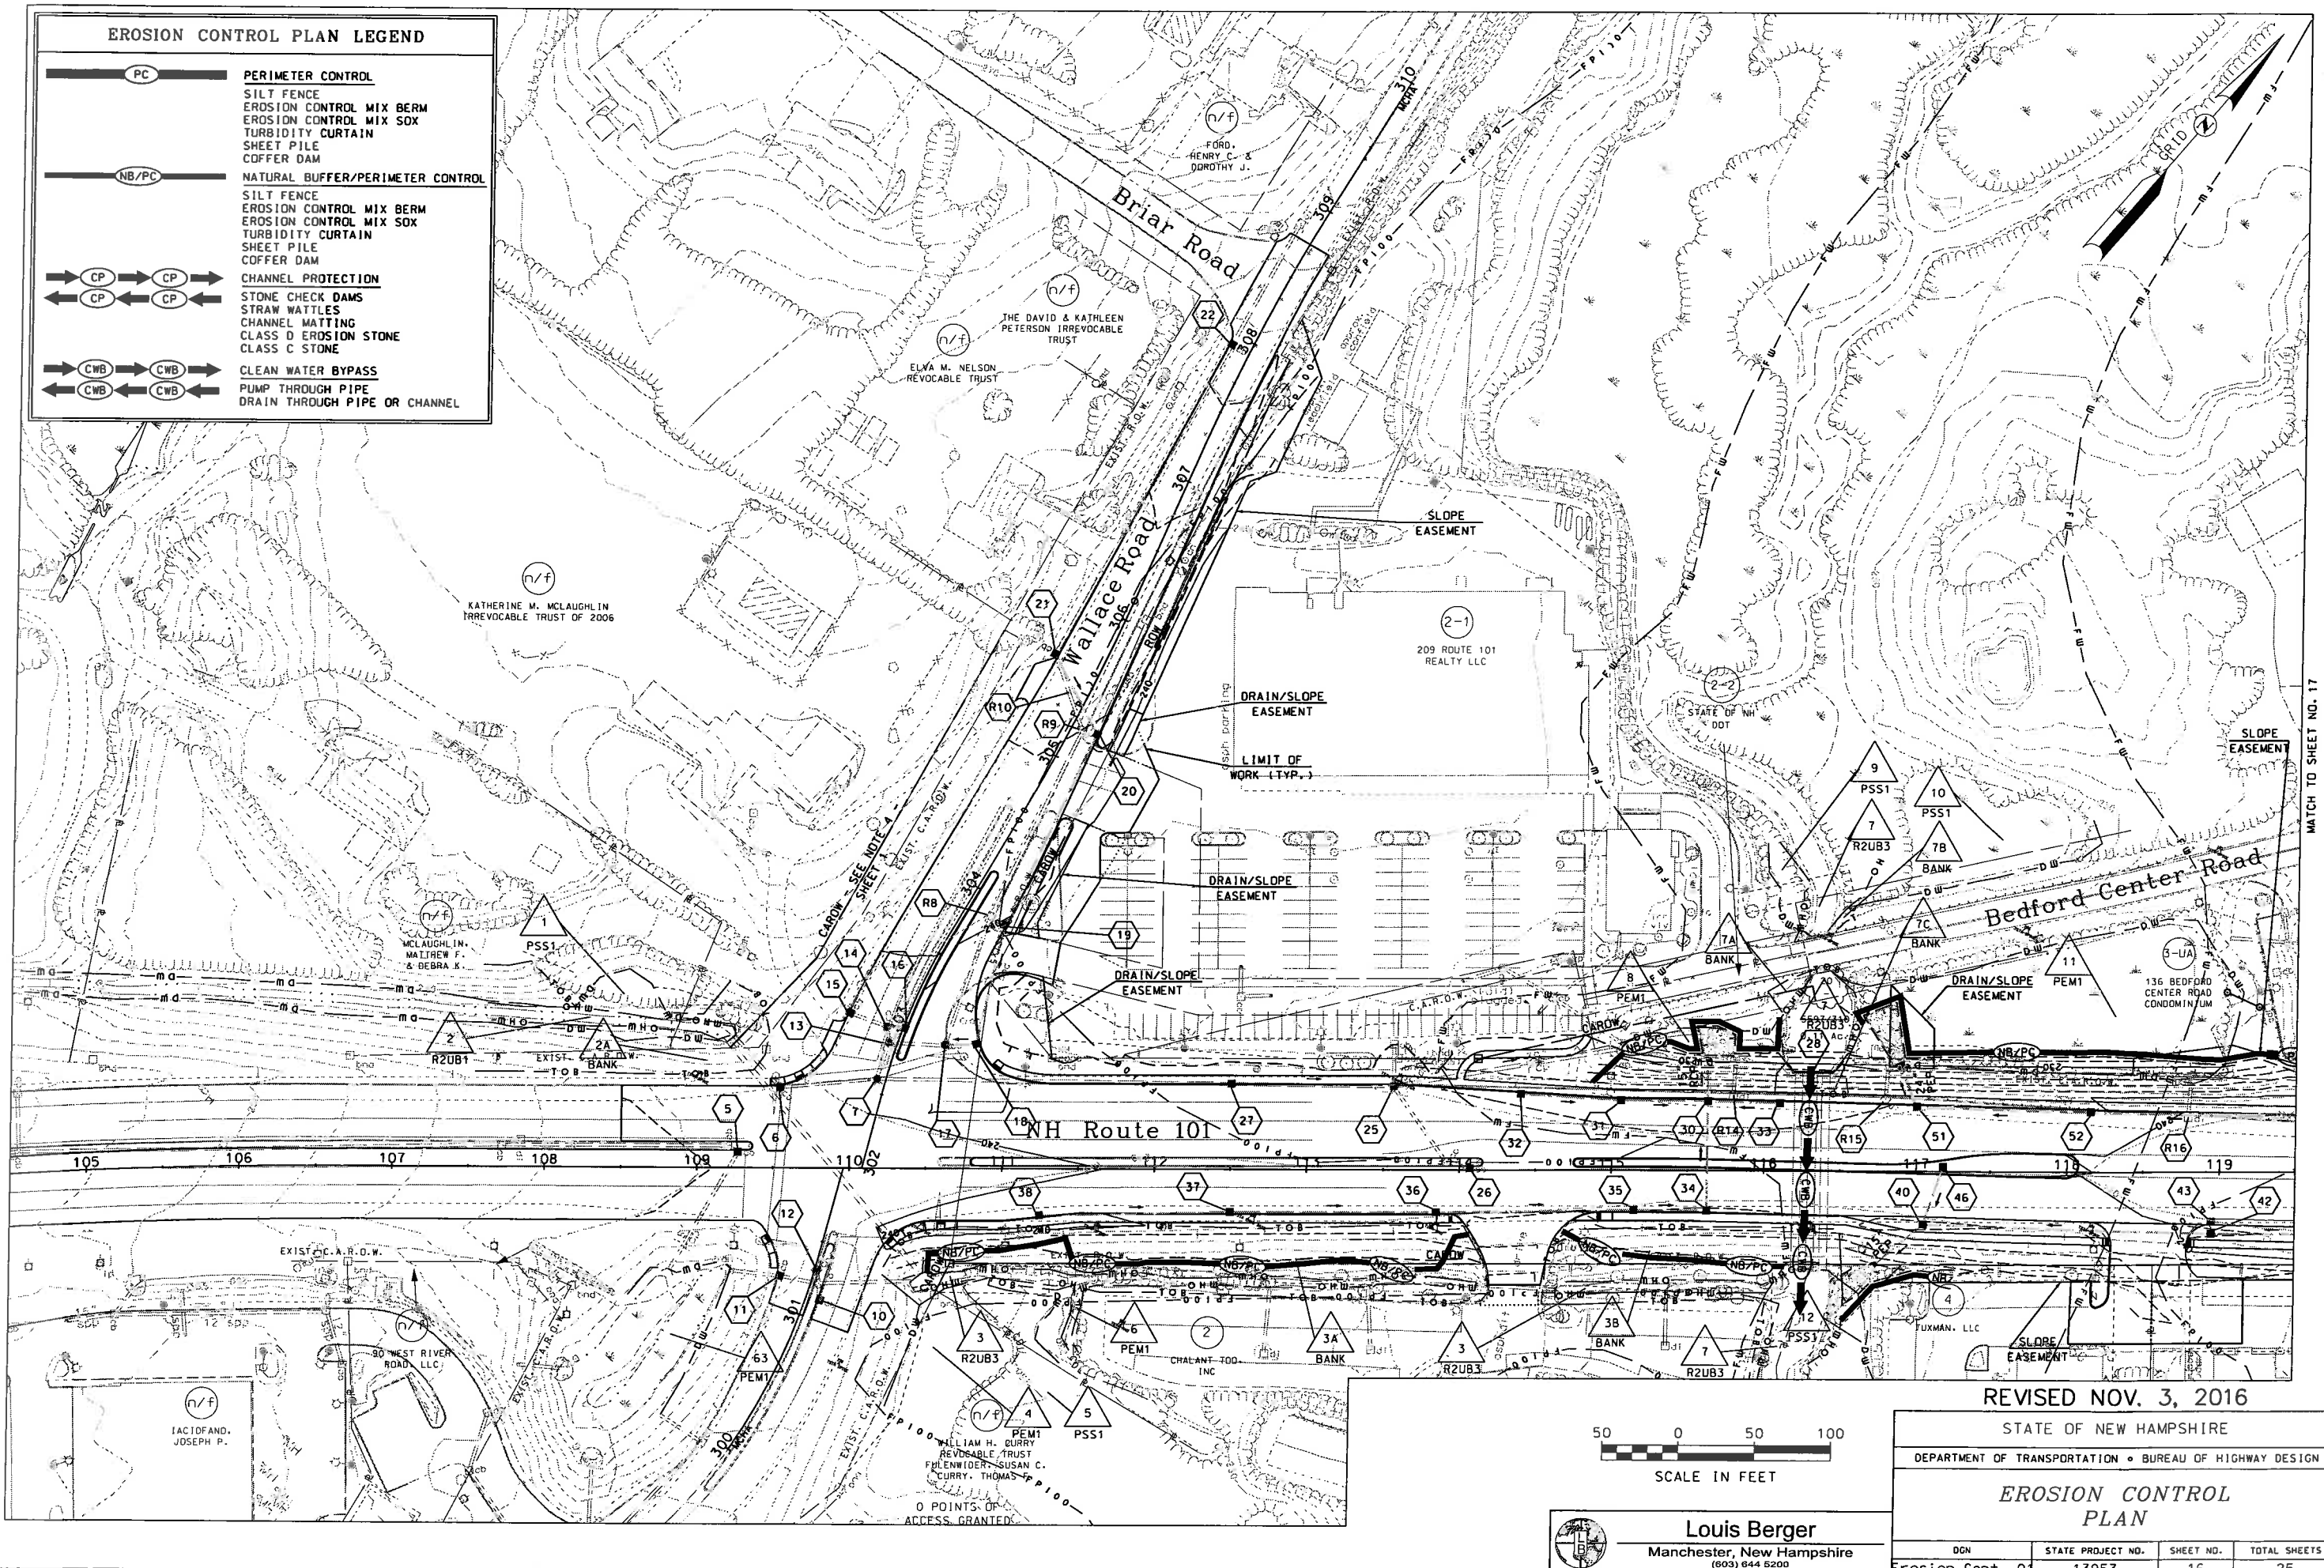[illegible]

MATCH TO SHEET NO. 17

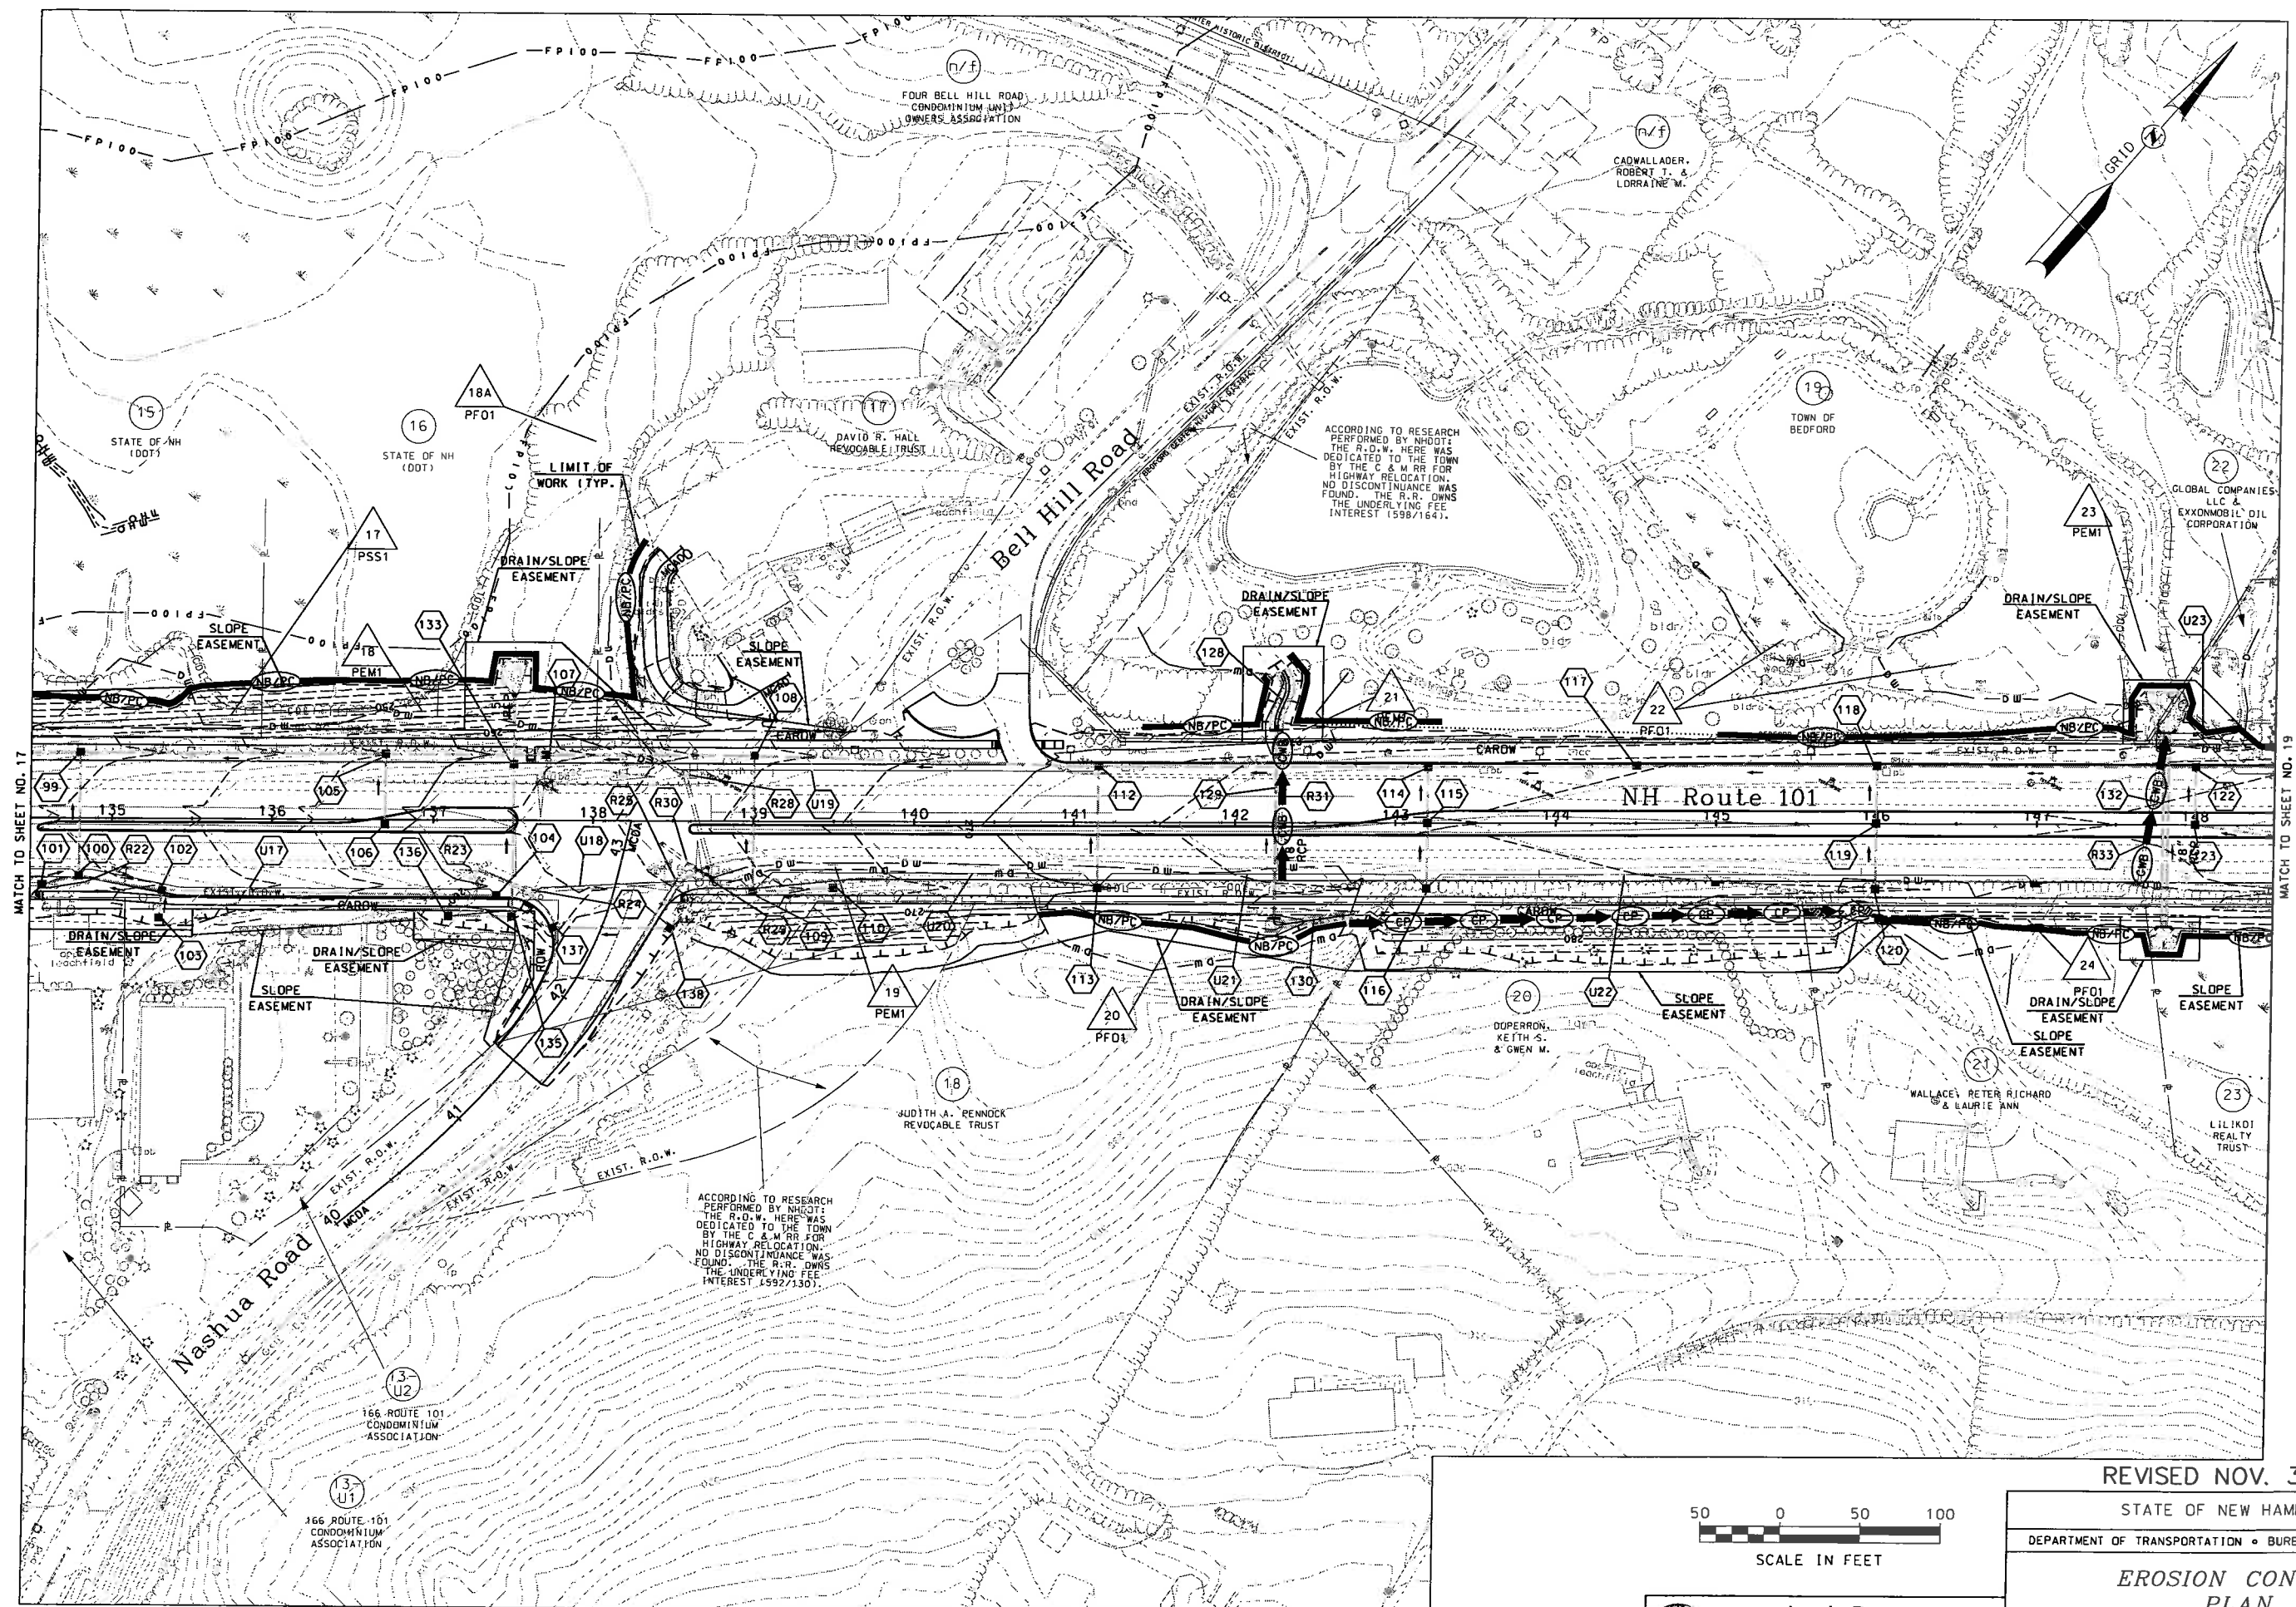[illegible]

REVISÉ NOV. 3, 2016

STATE OF NEW HAMPSHIRE

DEPARTMENT OF TRANSPORTATION • BUREAU OF HIGHWAY DESIGN


EROSION CONTROL
PLAN

| DGN | STATE PROJECT NO. | SHEET NO. | TOTAL SHEETS |
|------------------|-------------------|-----------|--------------|
| Erosion Cont. 03 | 13953 | 18 | 25 |

A horizontal scale bar with markings at 50, 0, 50, and 100. The bar is divided into segments: the first 50-foot segment is checkered, the next 50-foot segment is solid black, and the final 50-foot segment is solid white. Below the bar is the text "SCALE IN FEET".



Louis Berger
Manchester, New Hampshire
(603) 644 5200

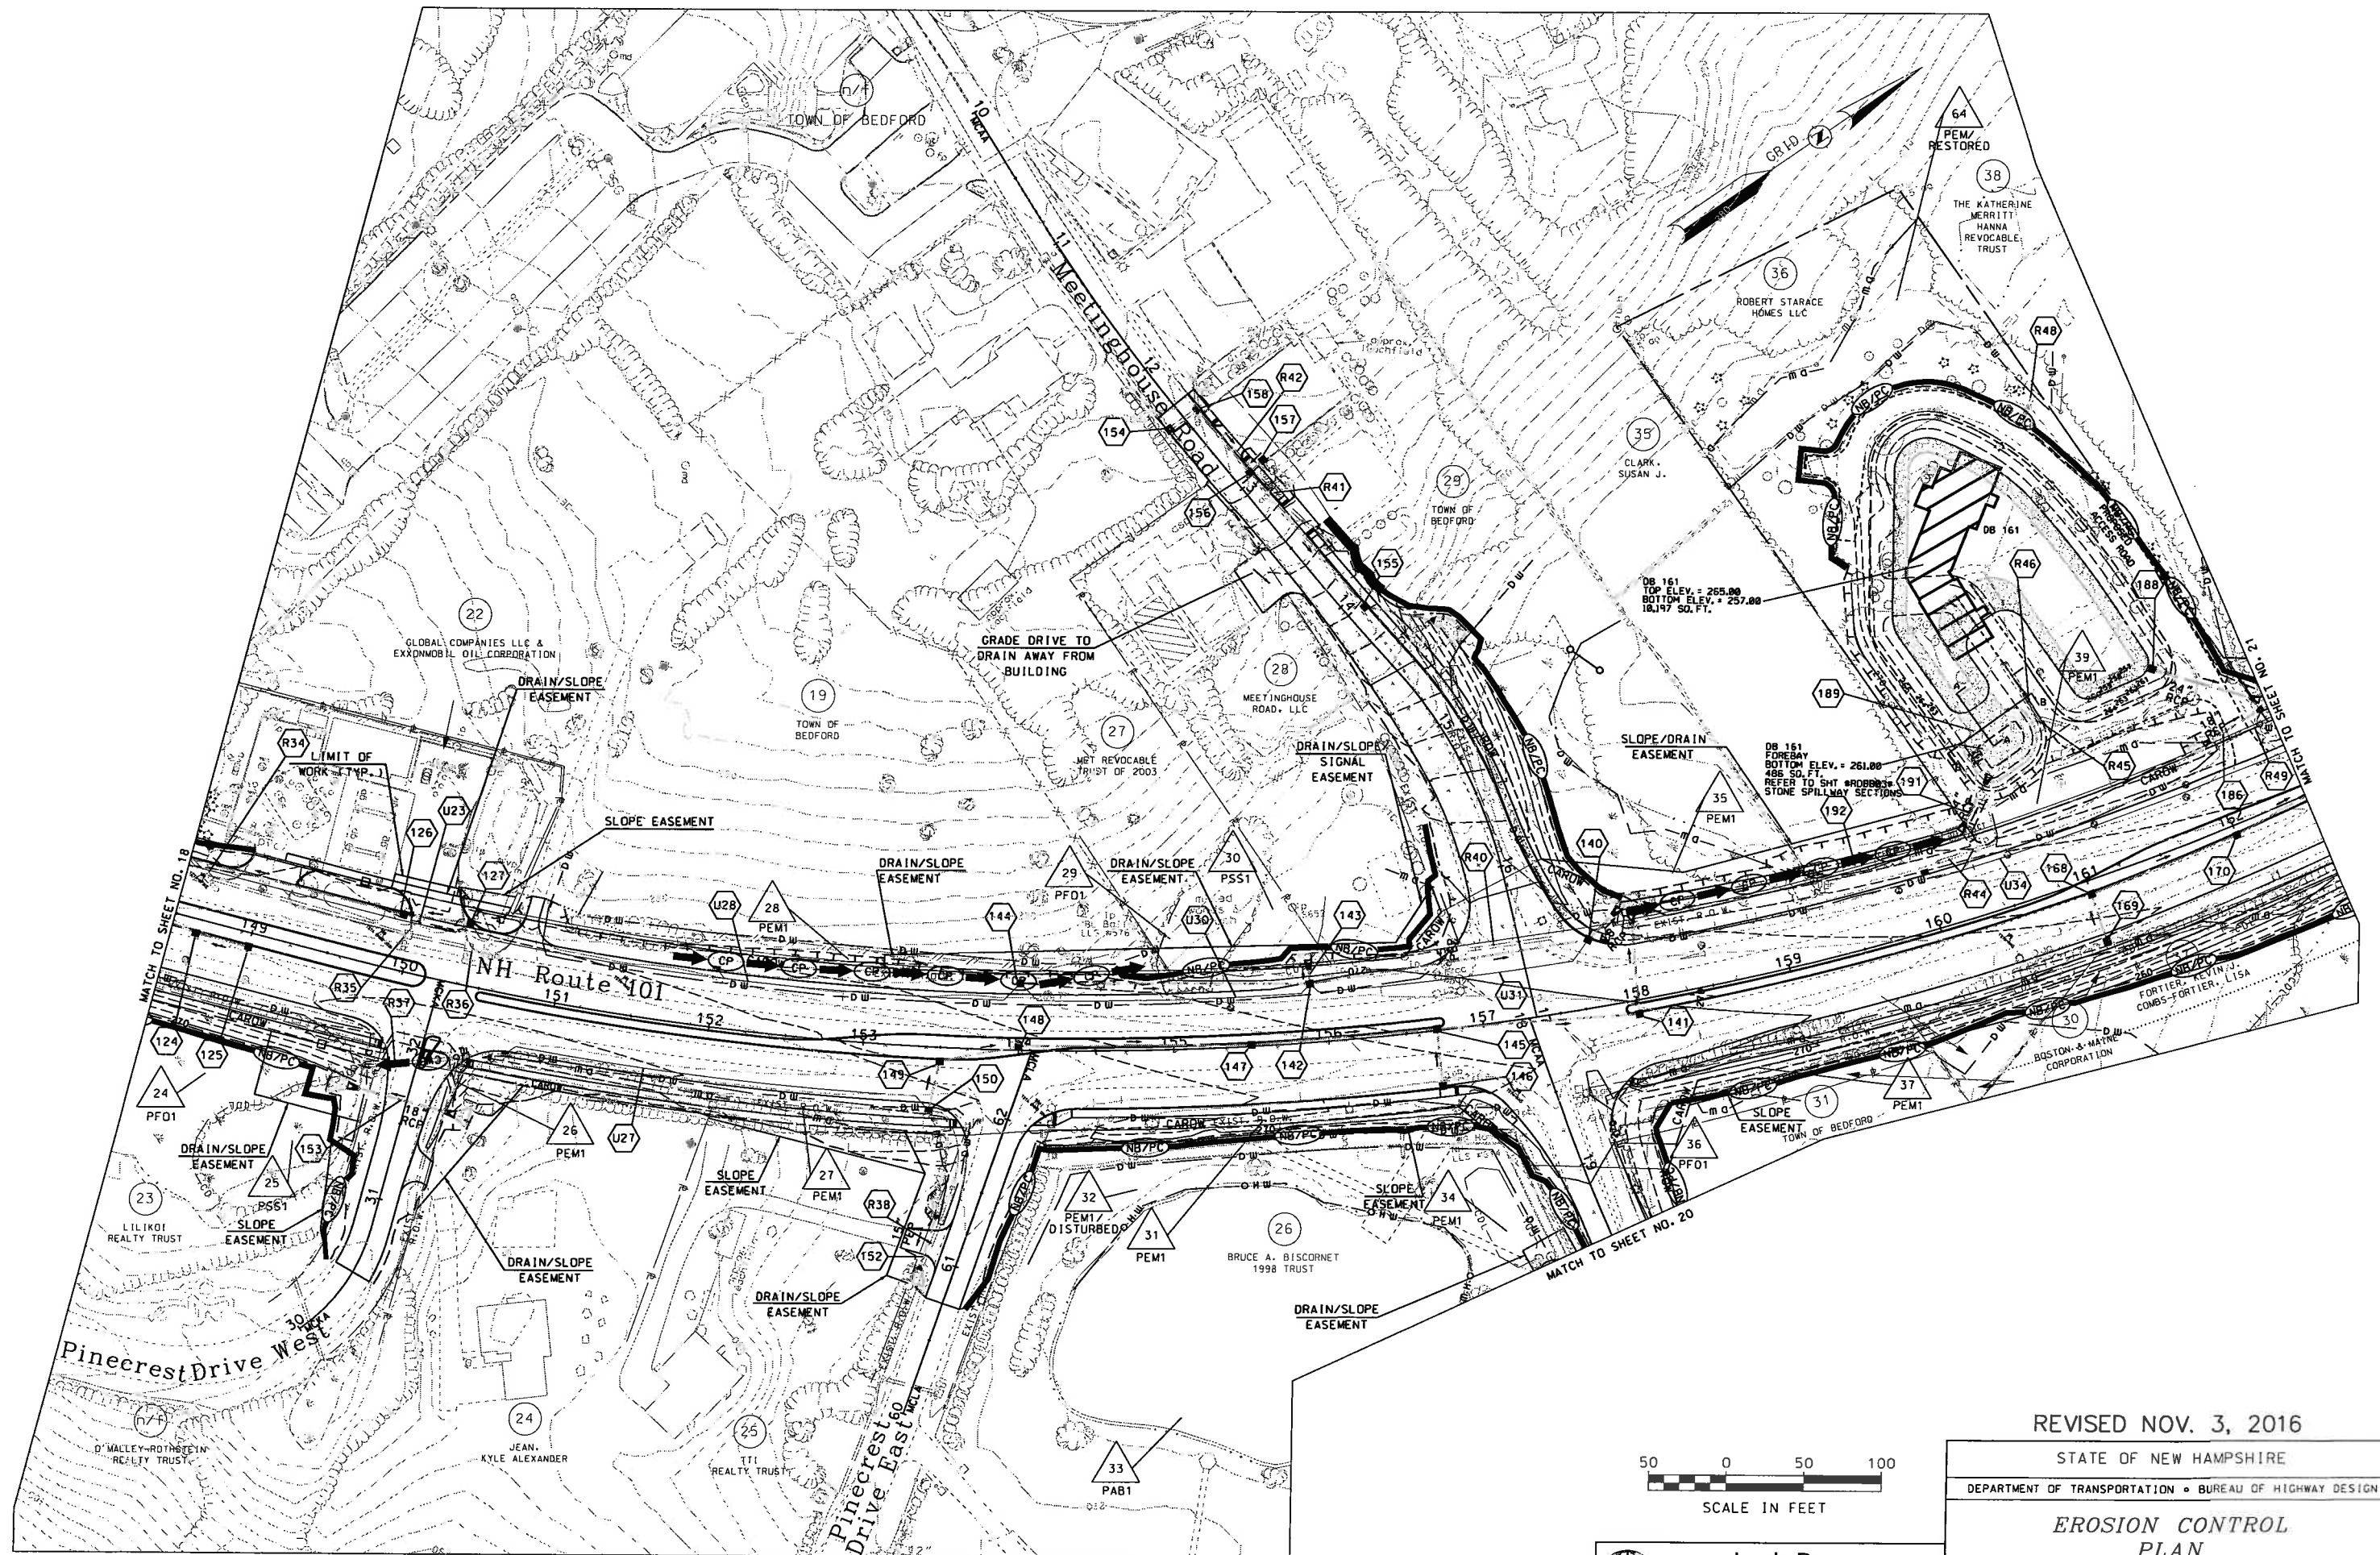[illegible]

REVISÉ NOV. 3, 2016


| |
|---------------------------------------------------------|
| STATE OF NEW HAMPSHIRE |
| DEPARTMENT OF TRANSPORTATION • BUREAU OF HIGHWAY DESIGN |

EROSION CONTROL
PLAN

| DGN | STATE PROJECT NO. | SHEET NO. | TOTAL SHEETS |
|------------------|-------------------|-----------|--------------|
| Erosion Cont. 04 | 13953 | 19 | 25 |

 **Louis Berger**
Manchester, New Hampshire
(603) 644 5200

| REVISIONS AFTER PROPOSAL | | | | STATION | | DATE | | NUMBER | | DATE | | DESCRIPTION | |
|--------------------------|---------------|-----|---------------|---------|--|------|--|--------|--|------|--|-------------|--|
| SDR PROCESSED | NEW DESIGN | ERW | DATE 08/23/16 | | | | | | | | | | |
| | SHEET CHECKED | LSF | DATE 08/23/16 | | | | | | | | | | |
| AS BUILT DETAILS | | | | | | | | | | | | | |


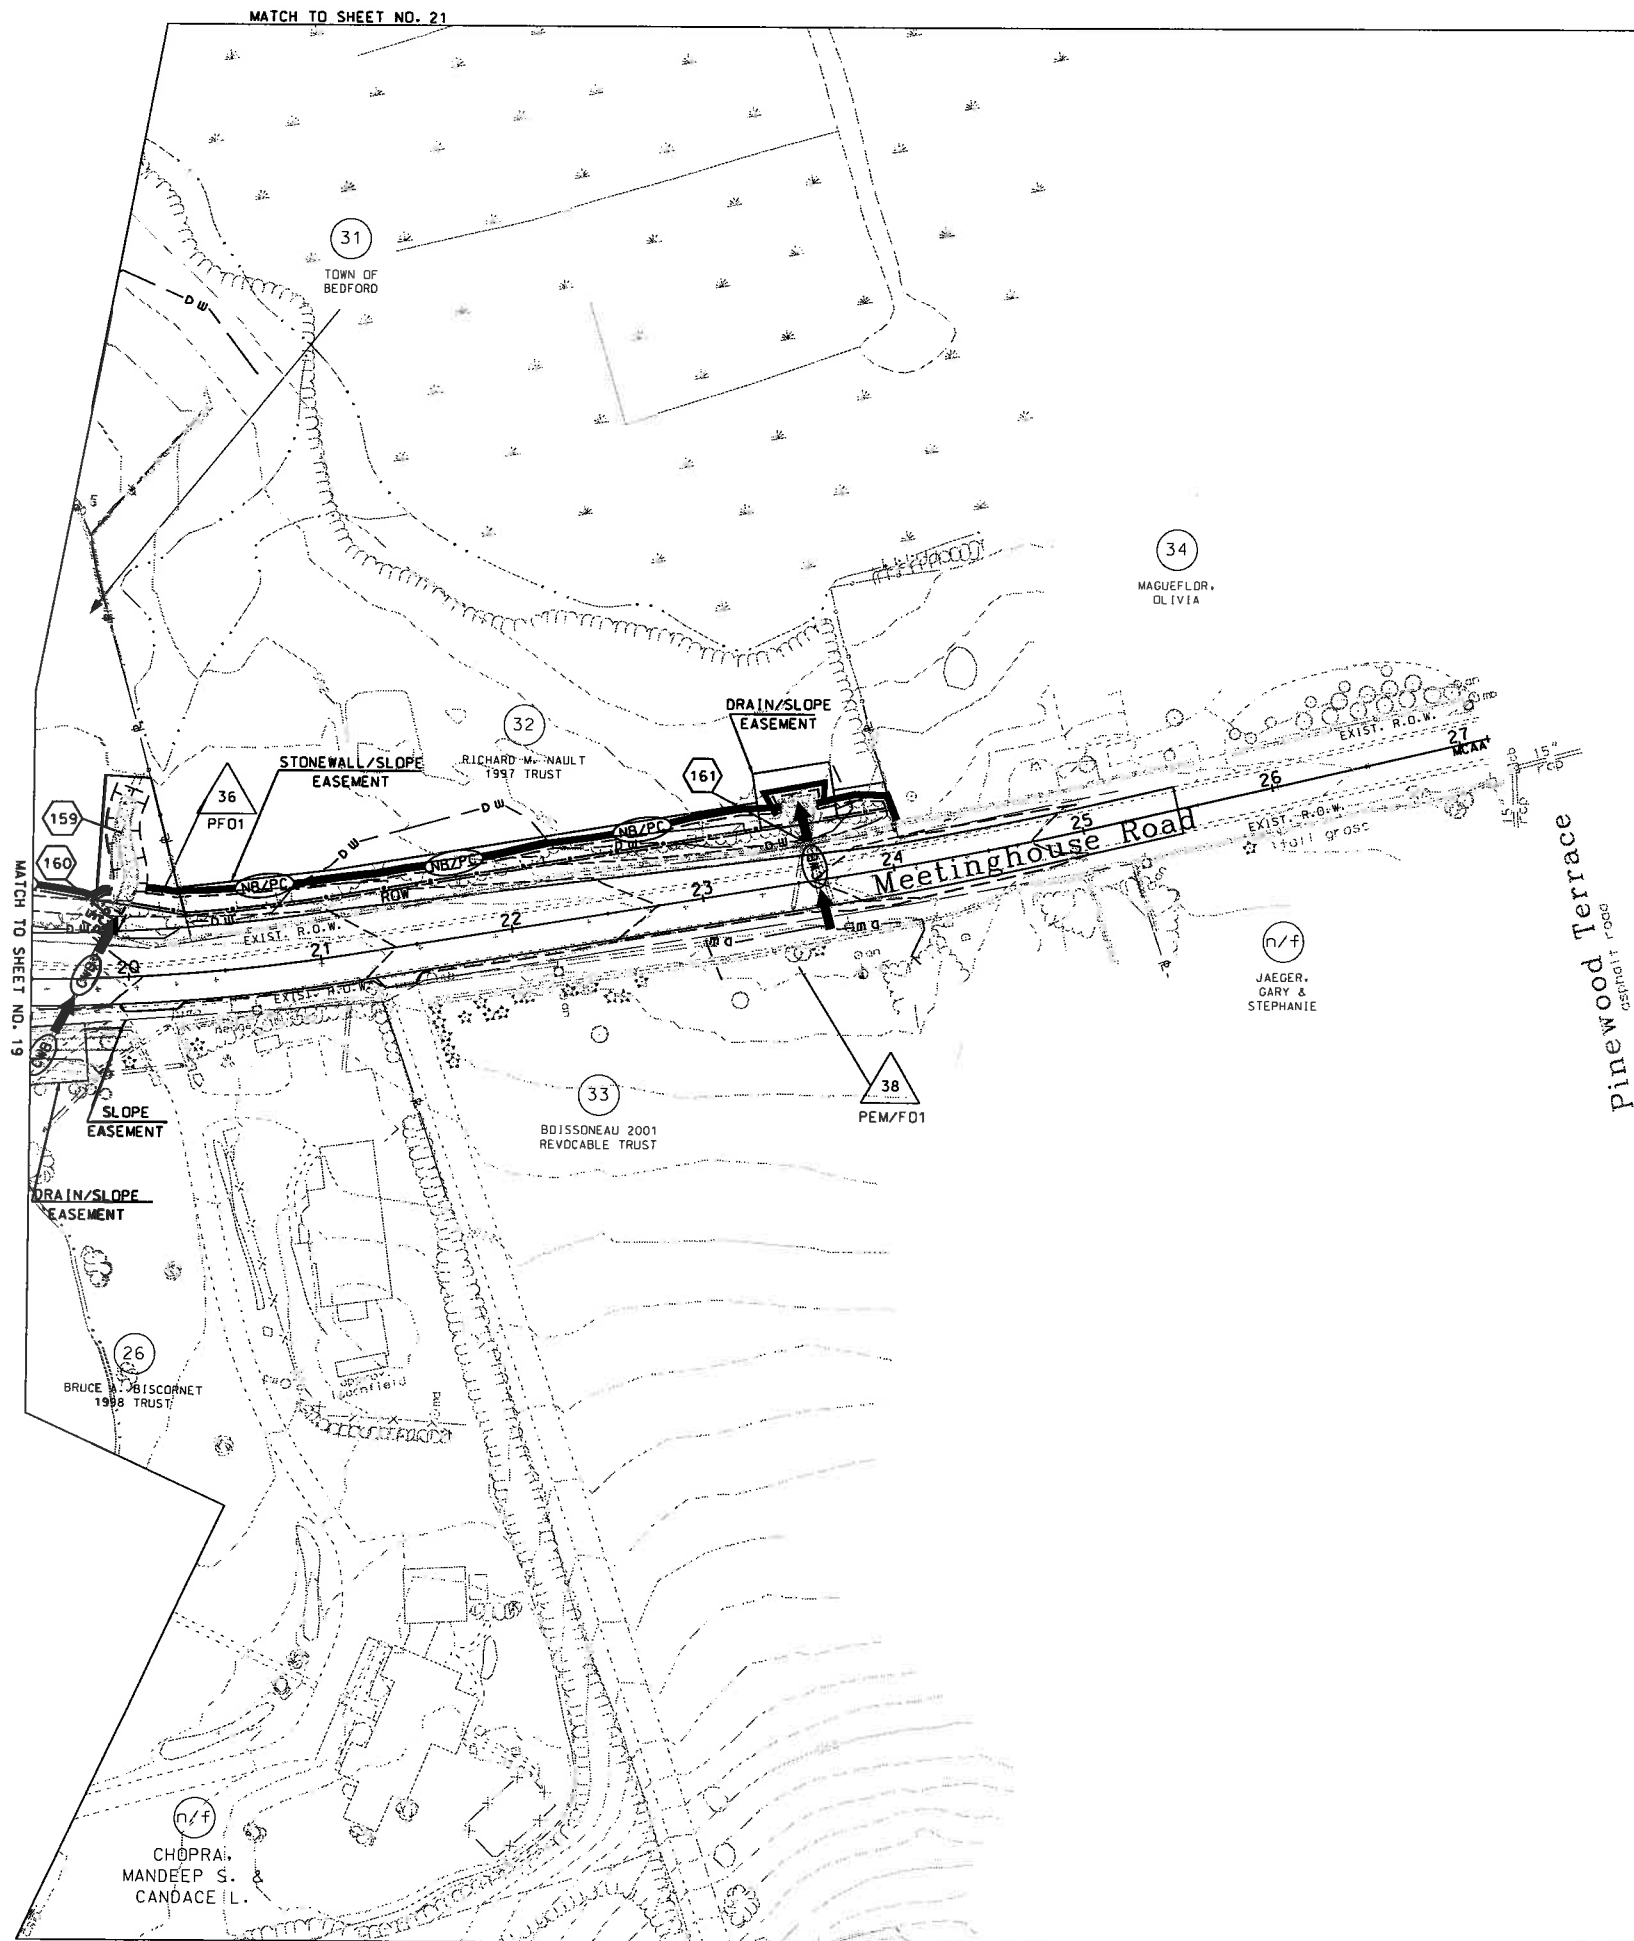


Louis Berger
Manchester, New Hampshire
(603) 644 5200

REVISED NOV. 3, 2016

| | | | |
|---------------------------------------------------------|-------------------|-----------|--------------|
| STATE OF NEW HAMPSHIRE | | | |
| DEPARTMENT OF TRANSPORTATION • BUREAU OF HIGHWAY DESIGN | | | |
| EROSION CONTROL PLAN | | | |
| DGN | STATE PROJECT NO. | SHEET NO. | TOTAL SHEETS |
| Erosion Cont. 05 | 13953 | 20 | 25 |

| REVISIONS AFTER PROPOSAL | | STATION | DATE | NUMBER | DESCRIPTION |
|--------------------------|---------------|---------|---------------|--------|-------------|
| SDR PROCESSED | NEW DESIGN | ERW | DATE 08/23/16 | | |
| | SHEET CHECKED | LSF | DATE 08/23/16 | | |
| AS BUILT DETAILS | | | DATE | | |

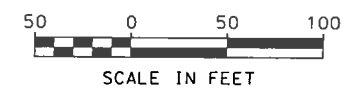
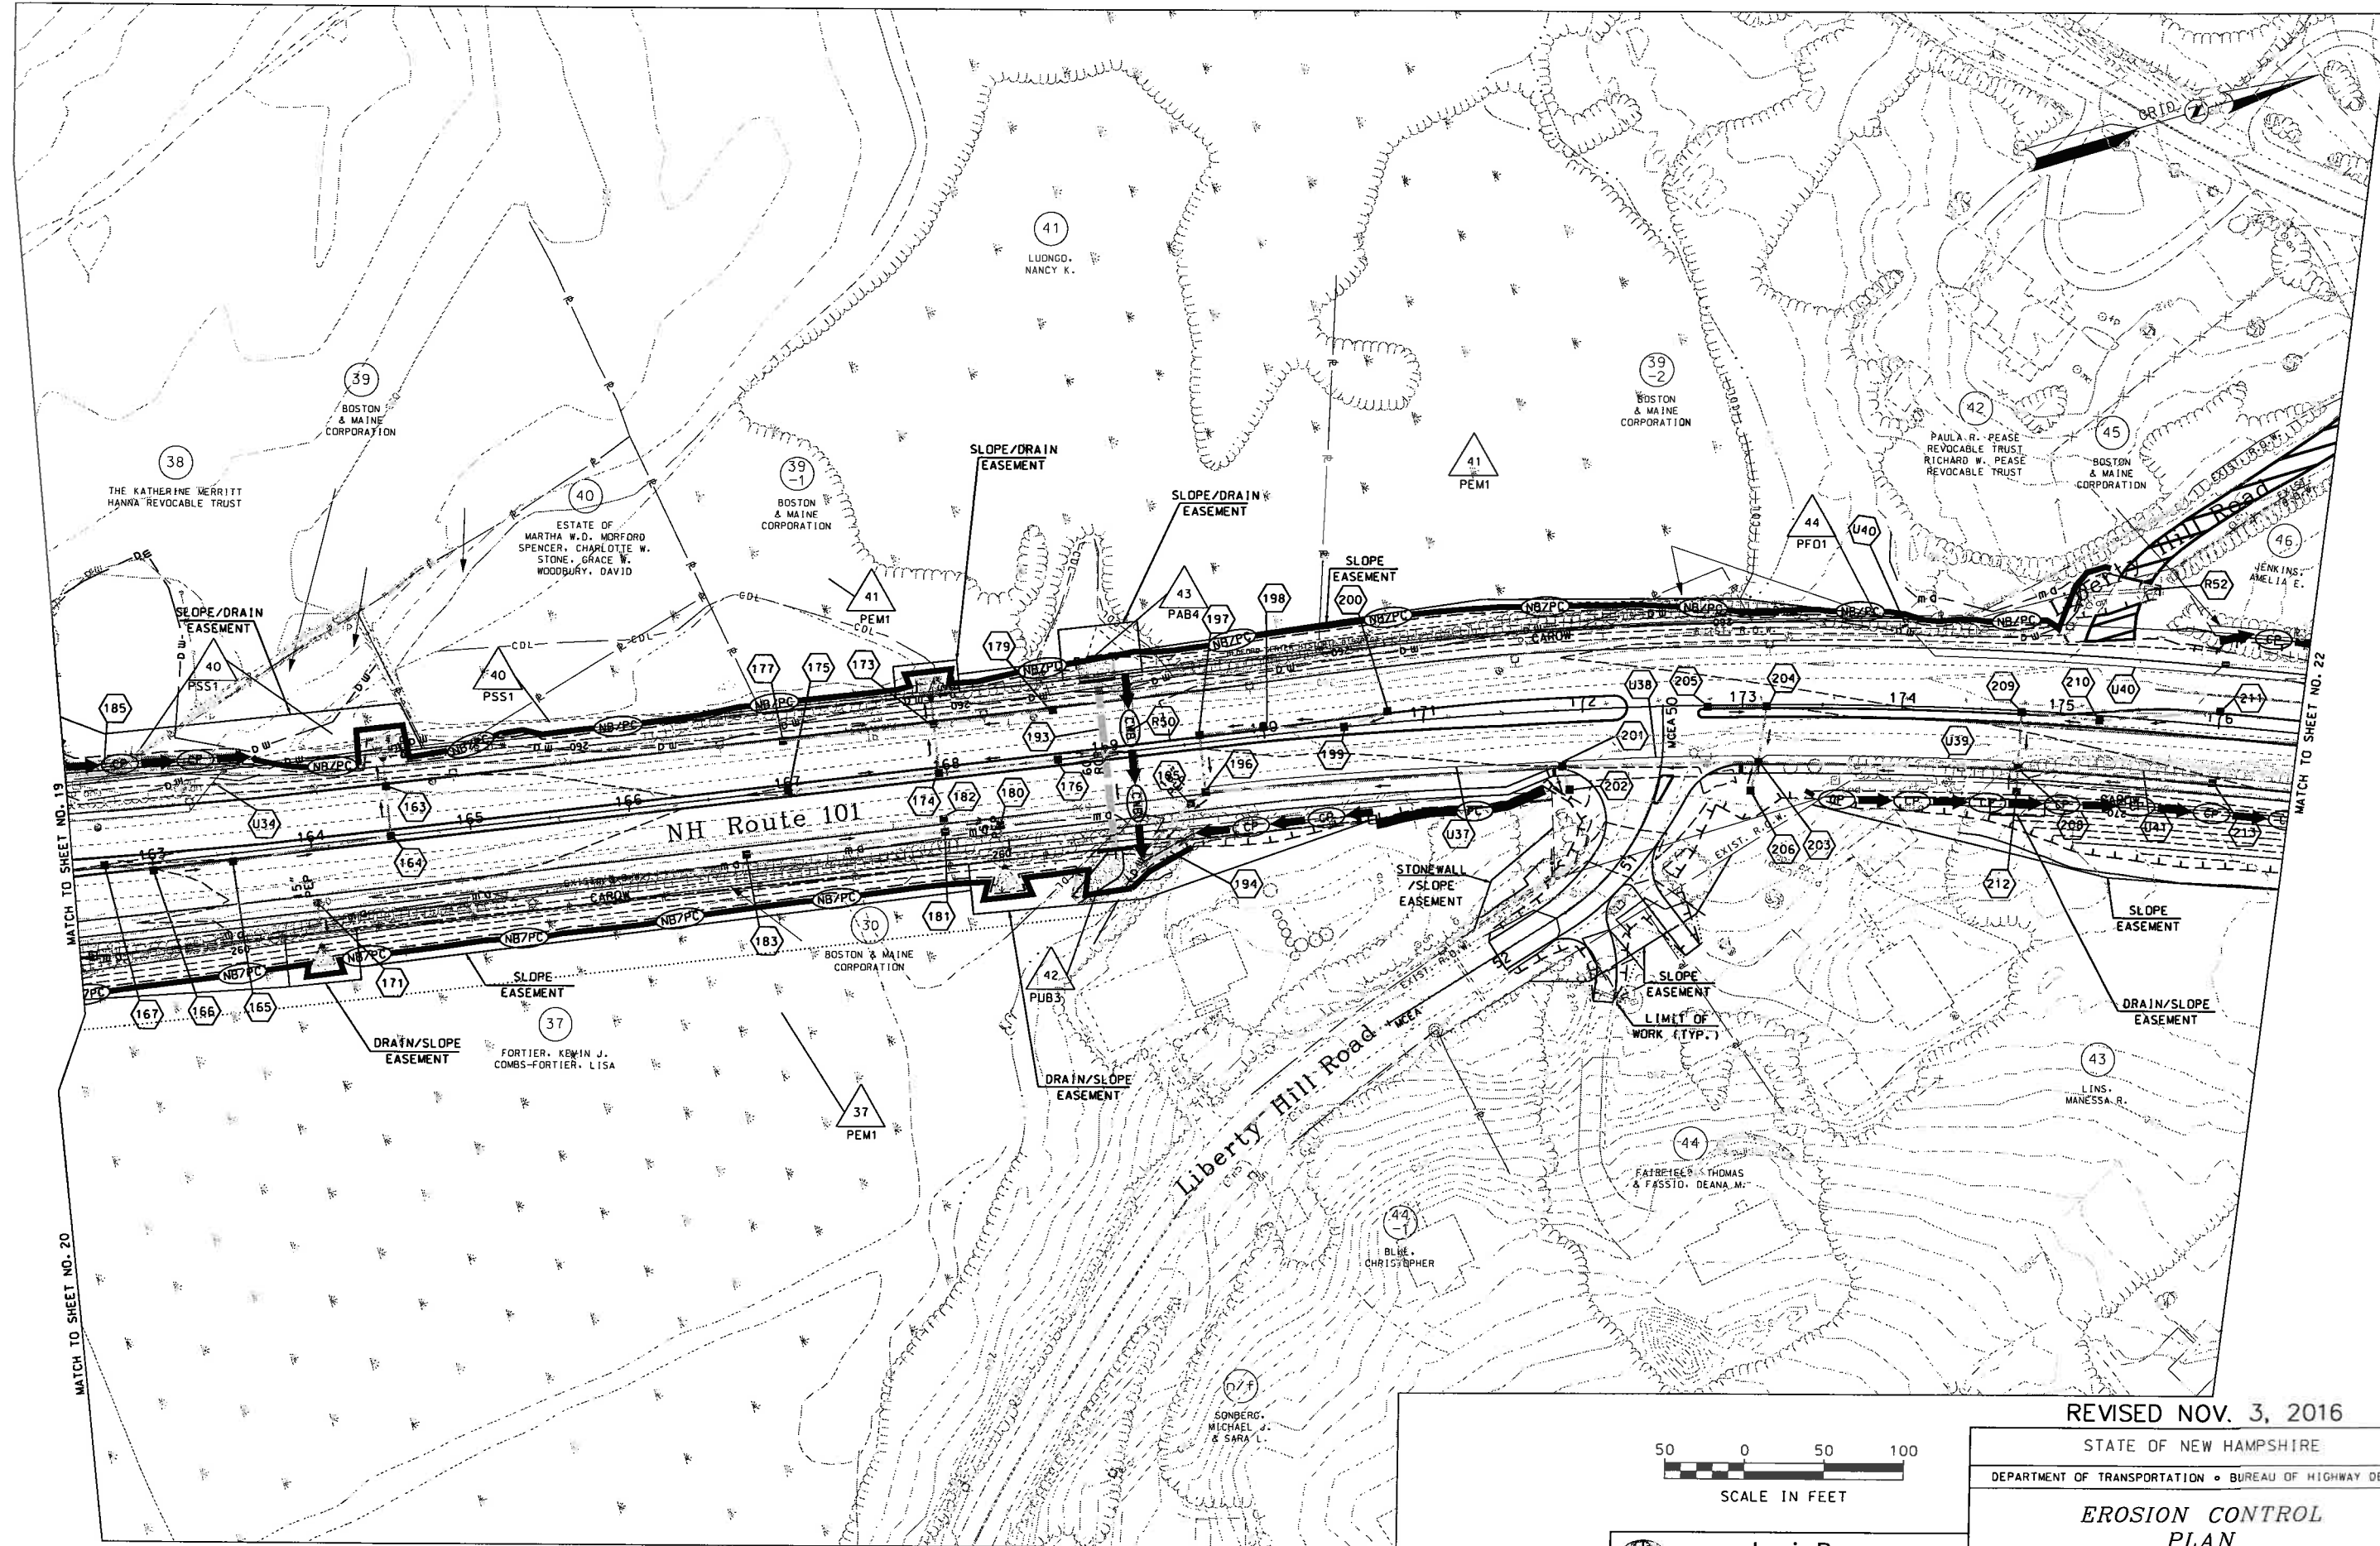



Louis Berger
 Manchester, New Hampshire
 (603) 644 5200

REVISED NOV. 3, 2016

| | | | |
|---------------------------------------------------------|-------------------|-----------|--------------|
| STATE OF NEW HAMPSHIRE | | | |
| DEPARTMENT OF TRANSPORTATION • BUREAU OF HIGHWAY DESIGN | | | |
| EROSION CONTROL PLAN | | | |
| DGN | STATE PROJECT NO. | SHEET NO. | TOTAL SHEETS |
| Erosion Cont. 08 | 13953 | 21 | 25 |


| REVISIONS AFTER PROPOSAL | | STATION | DESCRIPTION |
|--------------------------|---------------|---------|-------------|
| NUMBER | DATE | STATION | DESCRIPTION |
| SDR PROCESSED | DATE | | |
| NEW DESIGN | DATE 08/23/16 | | |
| SHEET CHECKED | DATE 08/23/16 | | |
| AS BUILT DETAILS | DATE | | |

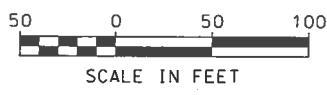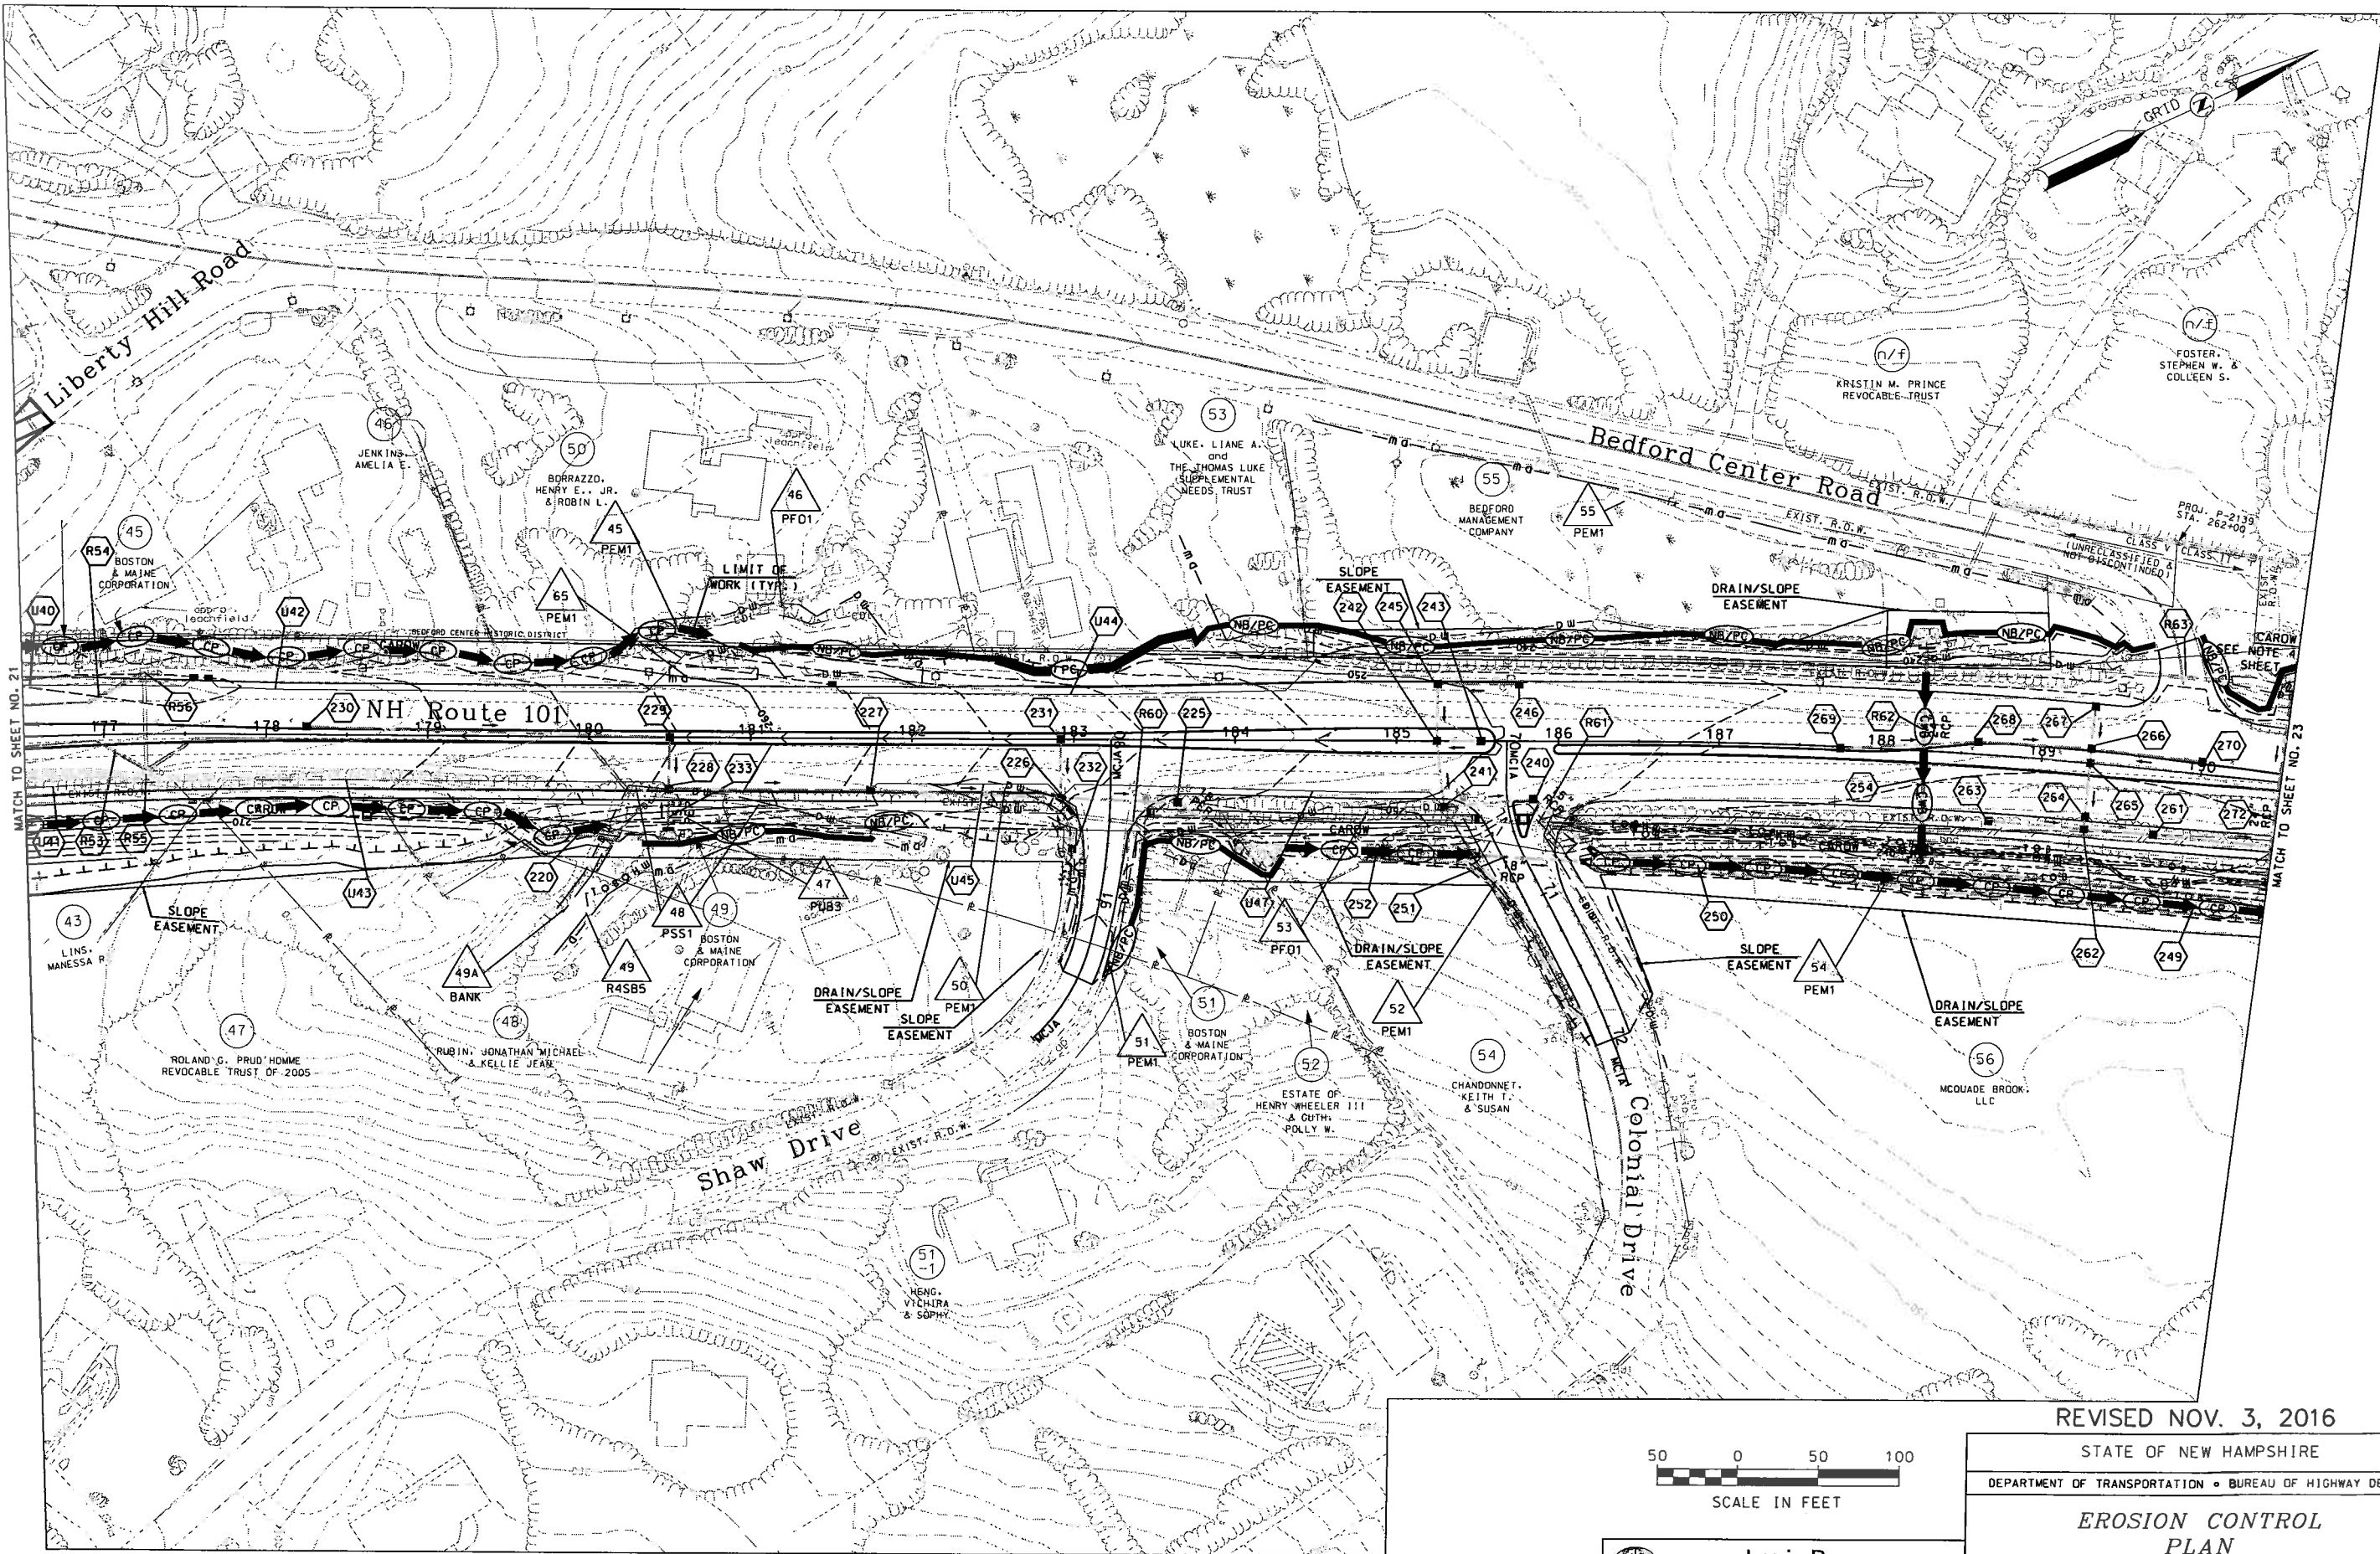

 **Louis Berger**
Manchester, New Hampshire
(603) 644 5200

| | | | |
|---------------------------------------------------------|-------------------|-----------|--------------|
| REVISED NOV. 3, 2016 | | | |
| STATE OF NEW HAMPSHIRE | | | |
| DEPARTMENT OF TRANSPORTATION • BUREAU OF HIGHWAY DESIGN | | | |
| EROSION CONTROL PLAN | | | |
| DGN | STATE PROJECT NO. | SHEET NO. | TOTAL SHEETS |
| Erosion Cont. 07 | 13953 | 22 | 25 |

| SDR PROCESSED | | REVISIONS AFTER PROPOSAL | | STATION | | DESCRIPTION | |
|------------------|-----|--------------------------|----------|---------|------|-------------|--|
| NEW DESIGN | ERW | DATE | 08/23/16 | NUMBER | DATE | STATION | |
| SHEET CHECKED | LSF | DATE | 08/23/16 | | | | |
| AS BUILT DETAILS | | DATE | | | | | |

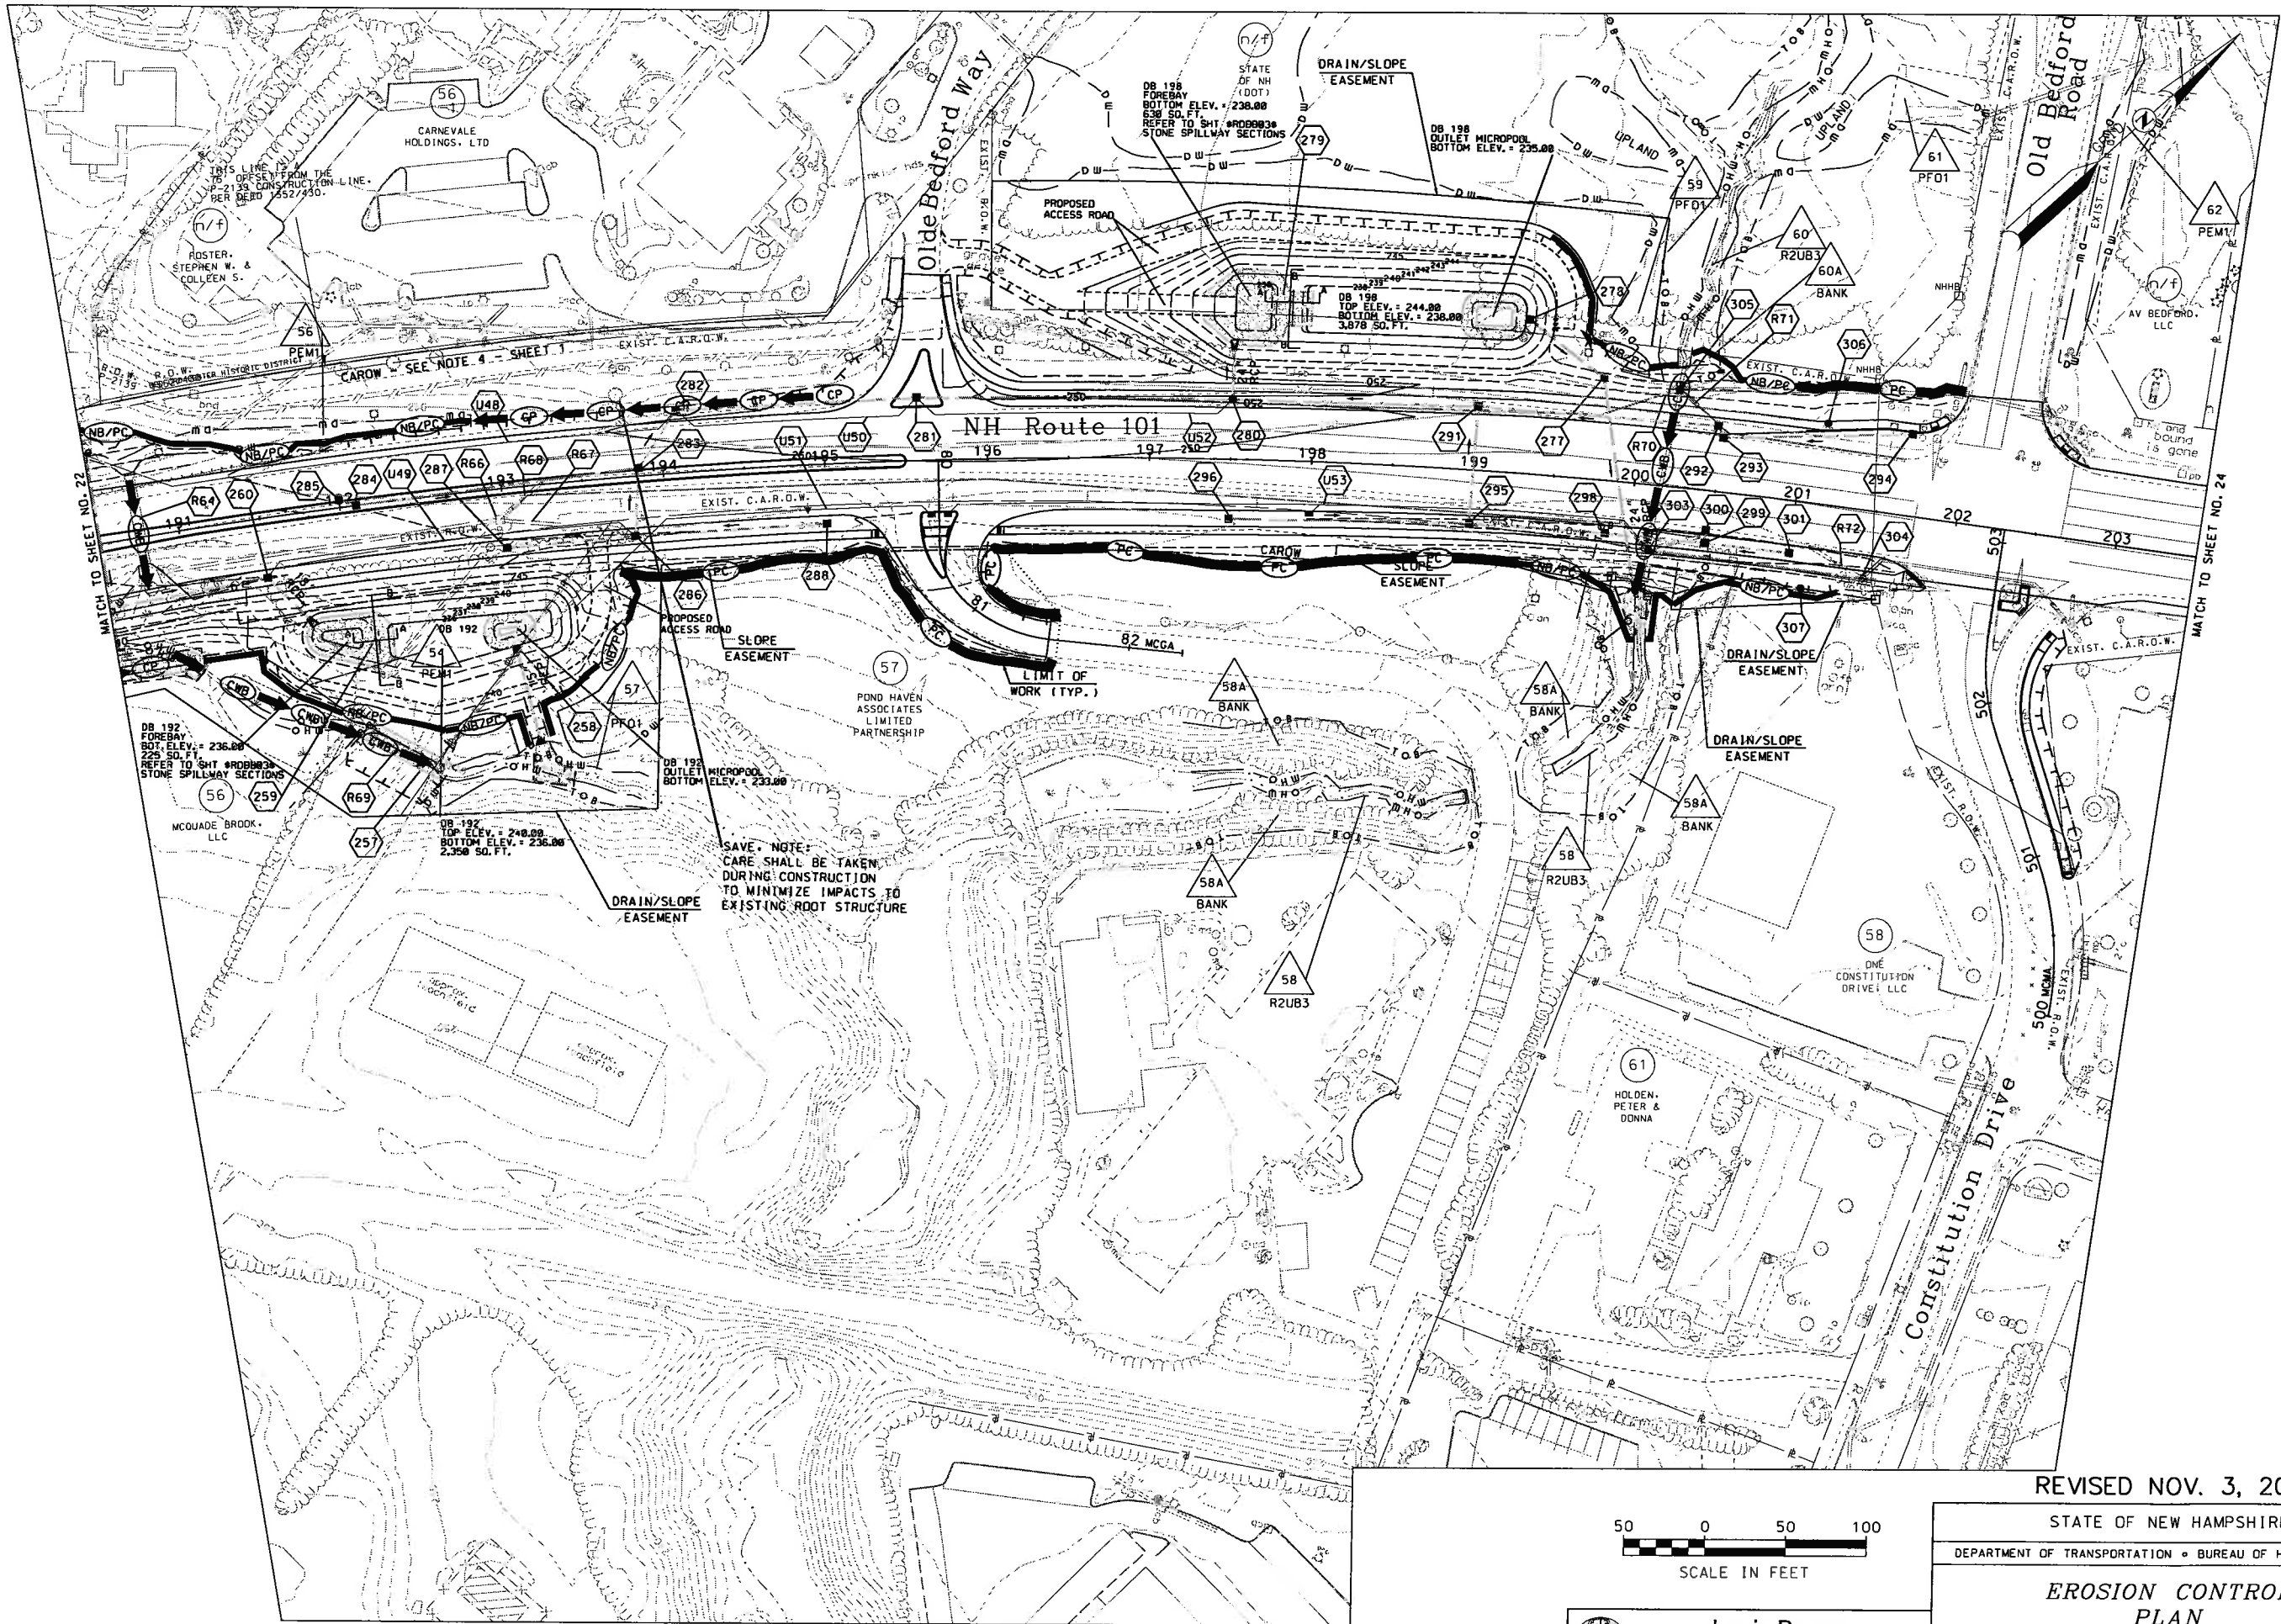

50 0 50 100
SCALE IN FEET

Louis Berger
Manchester, New Hampshire
(603) 644 5200


REVISED NOV. 3, 2016

STATE OF NEW HAMPSHIRE
DEPARTMENT OF TRANSPORTATION • BUREAU OF HIGHWAY DESIGN

EROSION CONTROL PLAN


| | | | |
|------------------|-------------------|-----------|--------------|
| DCN | STATE PROJECT NO. | SHEET NO. | TOTAL SHEETS |
| Erosion Cont. 08 | 13953 | 23 | 25 |


| | | | | | |
|------------------|-----|--------------------------|------|---------|-------------|
| SDR PROCESSED | | REVISIONS AFTER PROPOSAL | | | |
| NEW DESIGN | ERW | NUMBER | DATE | STATION | DESCRIPTION |
| SHEET CHECKED | LSF | | | | |
| AS BUILT DETAILS | | | | | |
| DATE | | | | | |
| DATE 08/23/16 | | | | | |
| DATE 08/23/16 | | | | | |

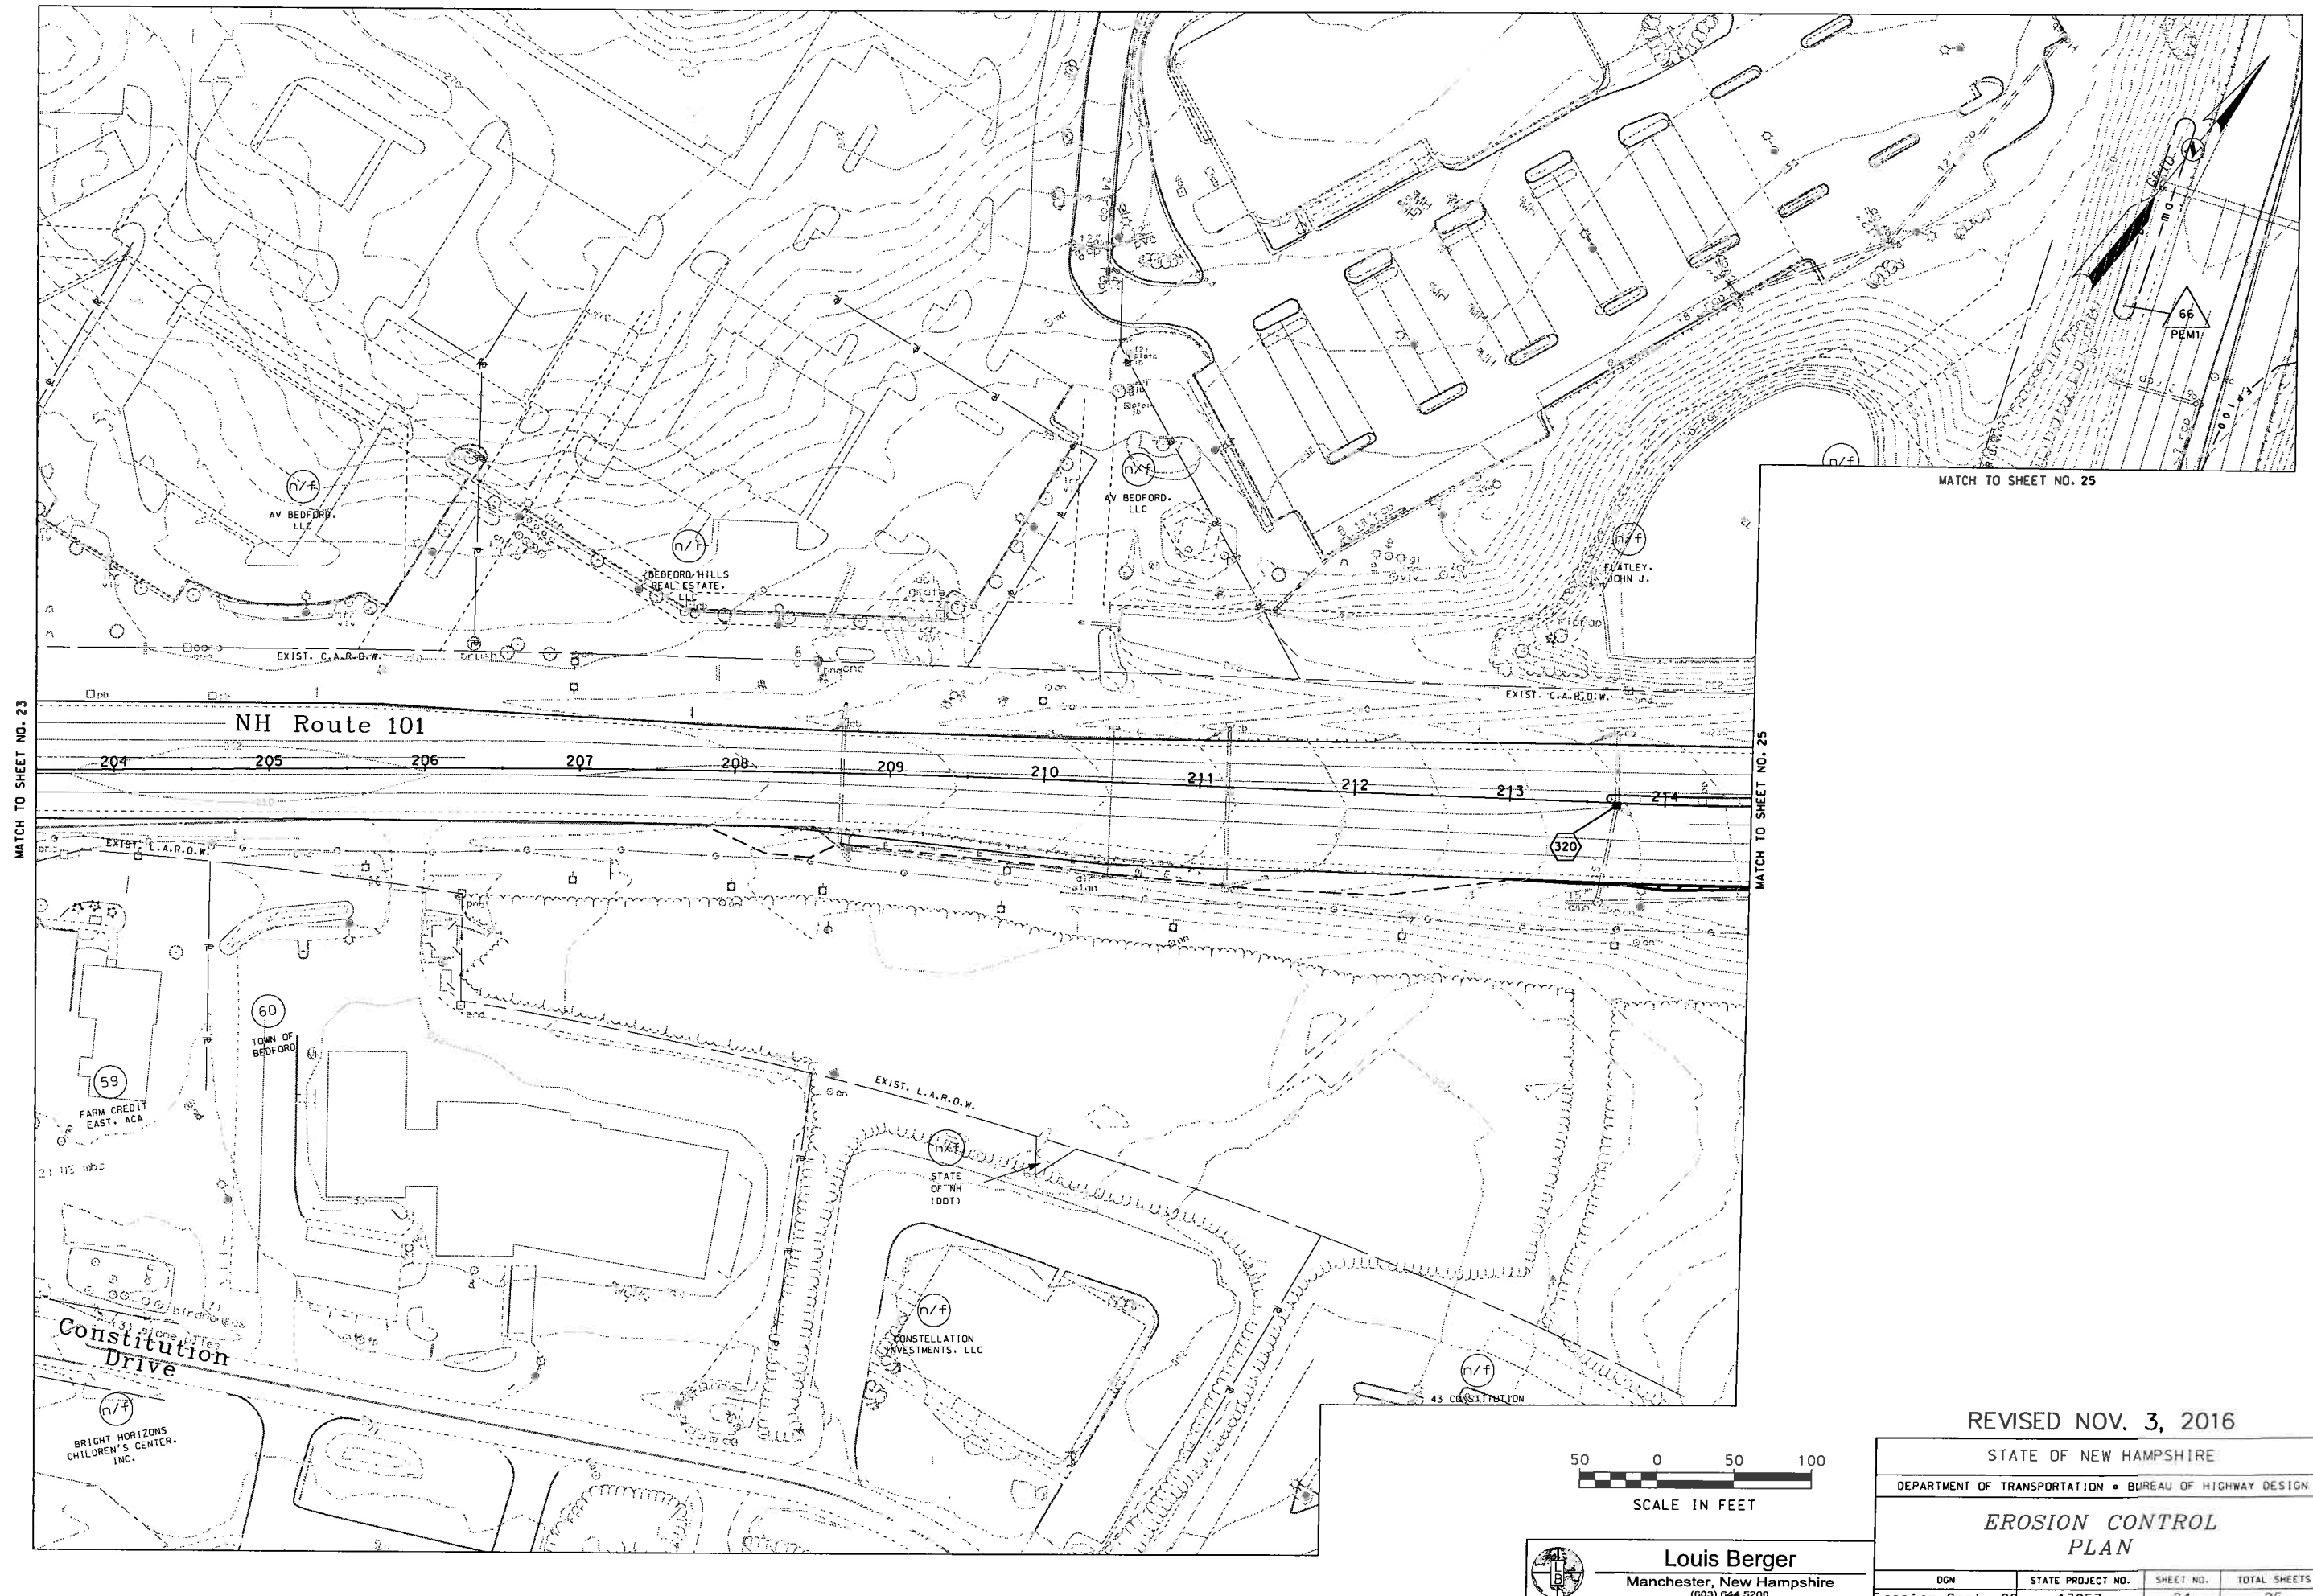

REVISED NOV. 3, 2016

| | | | |
|---------------------------------------------------------|-------------------|-----------|--------------|
| STATE OF NEW HAMPSHIRE | | | |
| DEPARTMENT OF TRANSPORTATION • BUREAU OF HIGHWAY DESIGN | | | |
| EROSION CONTROL PLAN | | | |
| DGN | STATE PROJECT NO. | SHEET NO. | TOTAL SHEETS |
| Erosion Cont. 09 | 13953 | 24 | 25 |

 **Louis Berger**
Manchester, New Hampshire
(603) 644 5200

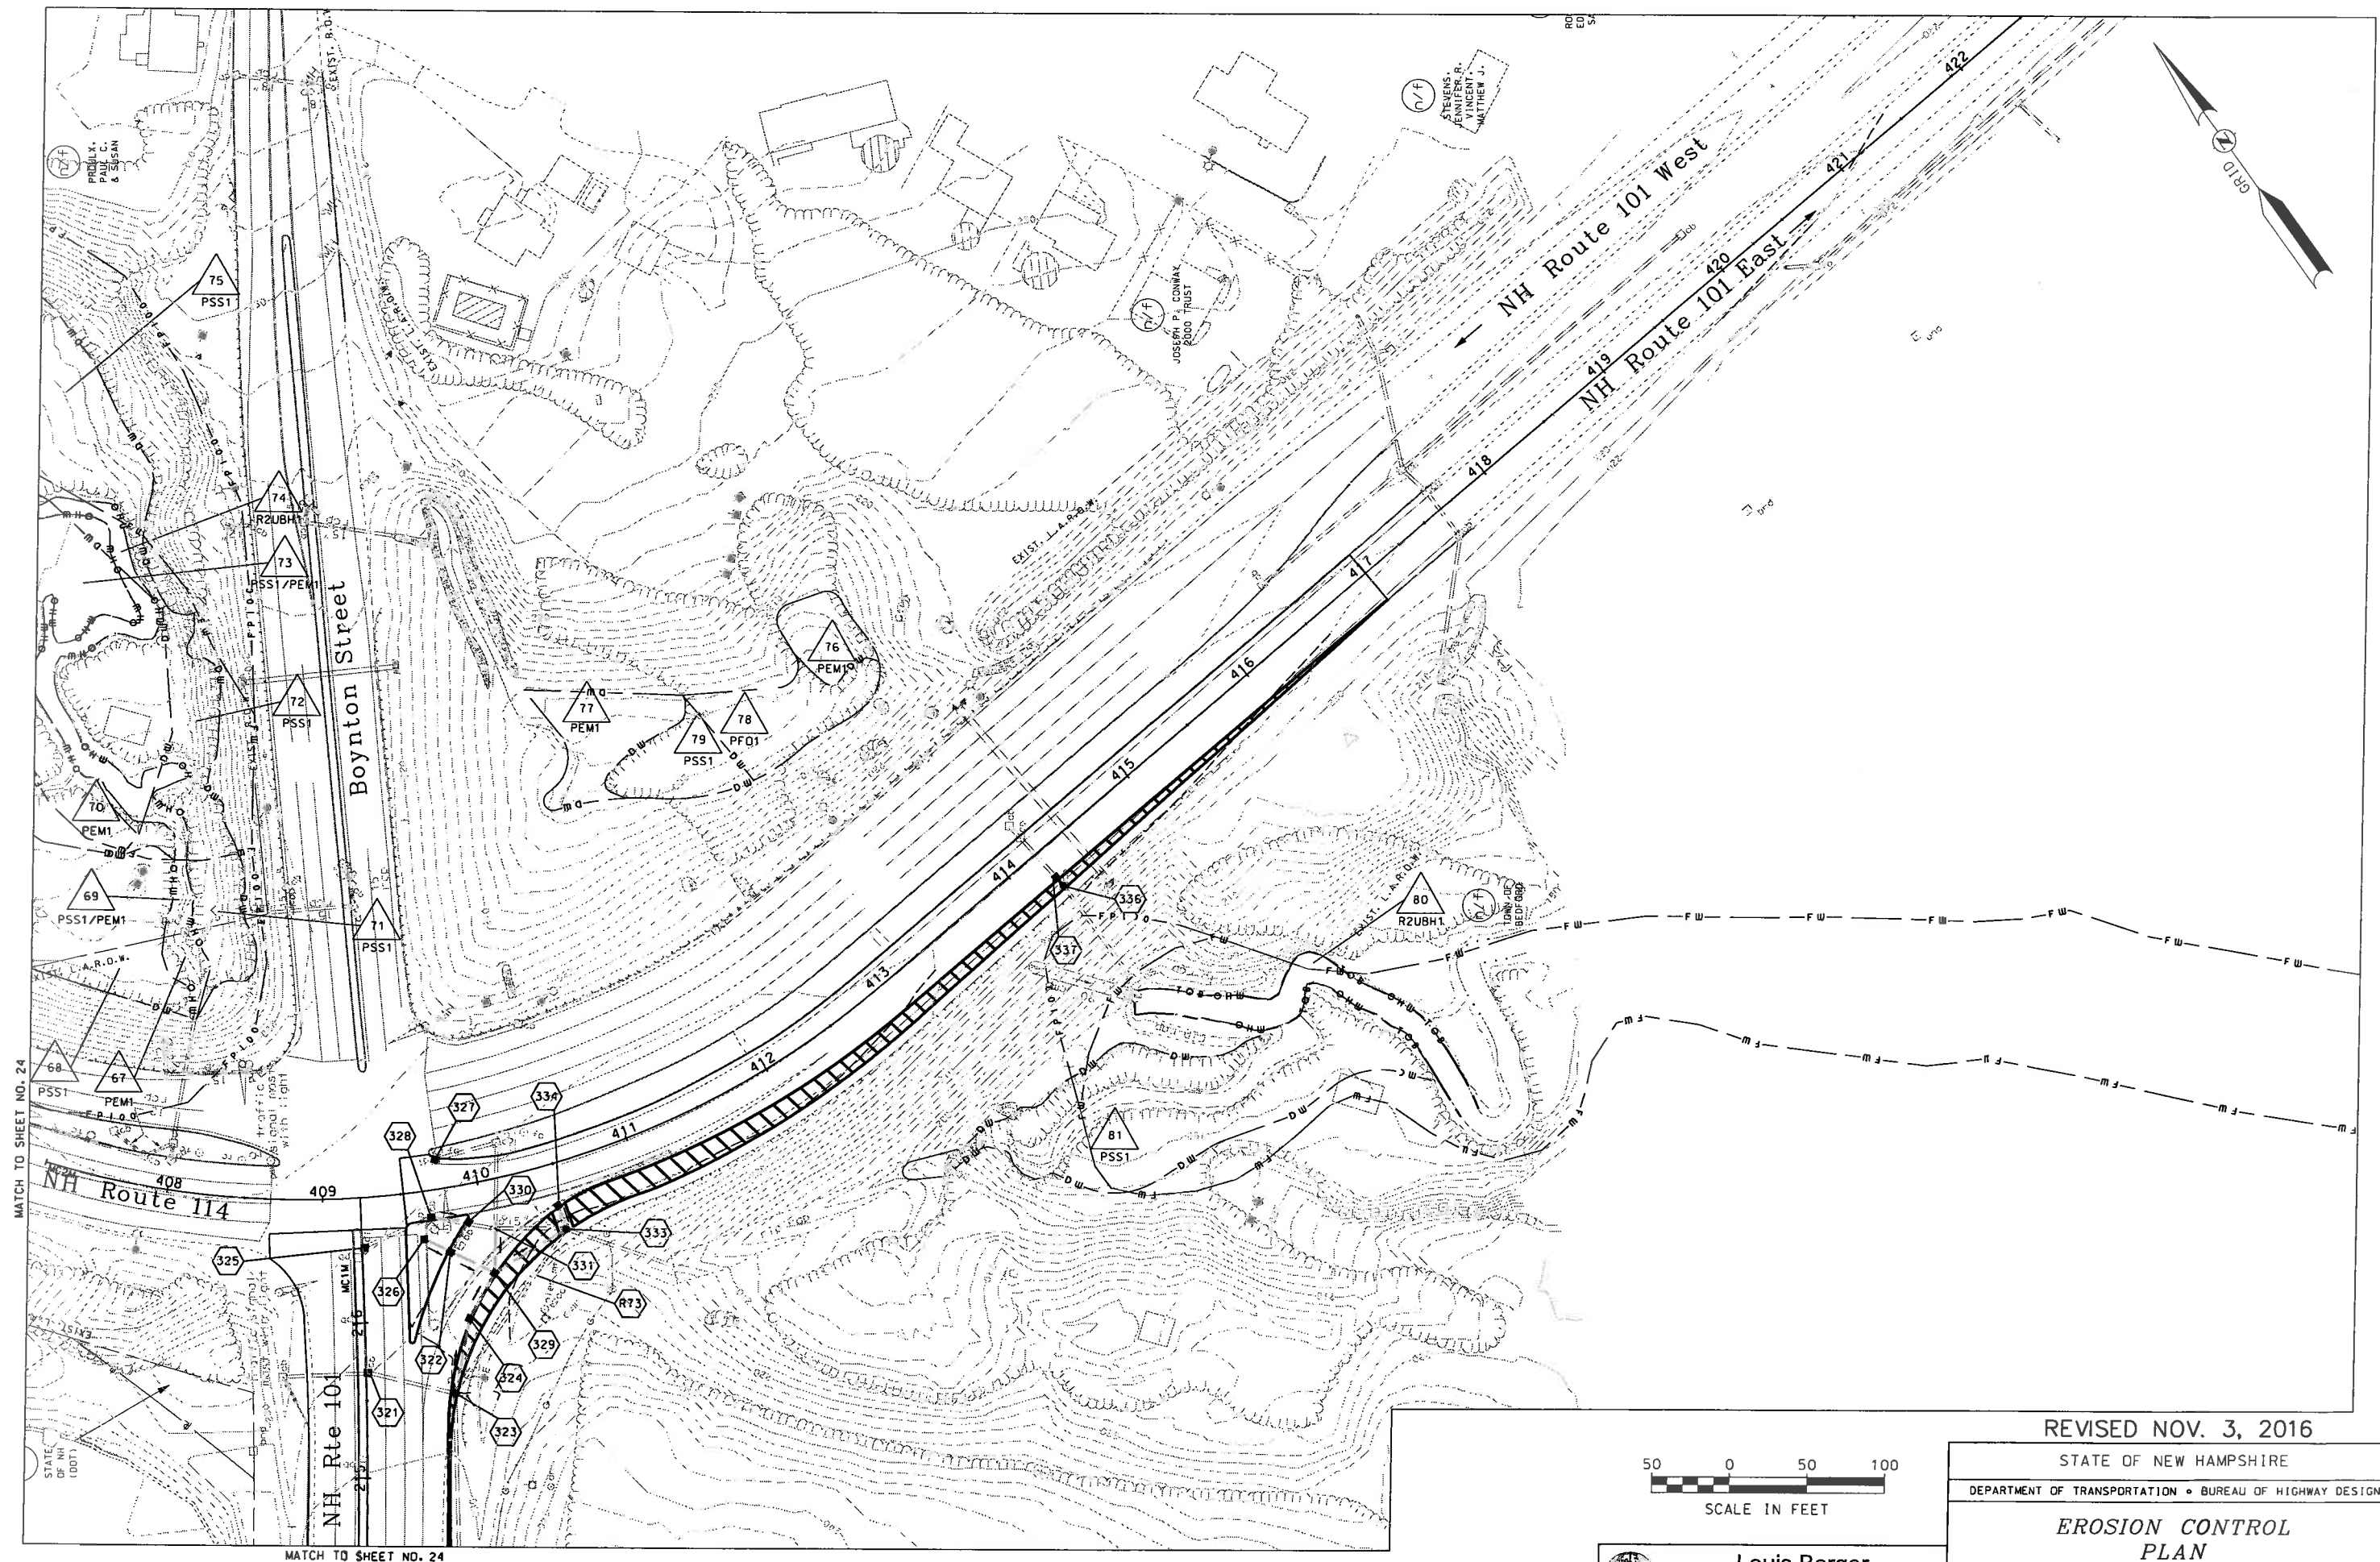[illegible]

REVISÉ NOV. 3, 2016

STATE OF NEW HAMPSHIRE

DEPARTMENT OF TRANSPORTATION • BUREAU OF HIGHWAY DESIGN

EROSION CONTROL
PLAN

| DGN | STATE PROJECT NO. | SHEET NO. | TOTAL SHEETS |
|------------------|-------------------|-----------|--------------|
| Erosion Cont. 10 | 13953 | 25 | 25 |